

MARSHALL

G 208

5-11-78

MISSISSIPPI BOARD OF WATER COMMISSIONERS
416 North State Street
Jackson, Mississippi 39201

WATER WELL DRILLERS LOG

5-11-78 date well completed

1978 Deant Kest Bunker well firm name

Marshall county well located

| LANDOWNER: | description of formations encountered | from | to |
|------------------------------------------------------------------------------------------------------------------|---------------------------------------|------|-----|
| James TAYLOR Holly SPR. r.s.s. miss. (mailing address) | clay | 0 | 20 |
| WELL LOCATION: sec. 23 T 2 N R 2 E (5) miles NORTH of Hudsonville (distance) (direction) (nearest town) | sand | 20 | 190 |
| WELL PURPOSE: pwellings (home, irrigation, municipal, industrial) | | | |
| WELL COMPLETION DATA: | | | |
| (1) diameter (inches) 4" | | | |
| (2) total depth (feet) 190 feet | | | |
| (3) static water level (feet) 120 below top of ground. | | | |
| (4) casing PVC 190 feet (material) (depth) | | | |
| (size) if telescope see back. | | | |
| (5) screen 2 ft. 183 feet (length) (depth to top) | | | |
| 4" gravel wall (size) (material) | | | |
| (6) pump 3/4 14 (HP) (yield gpm) | | | |
| (type power) | | | |
| (7) electric log slot (yes or no) | | | |
| (organization running log) | | | |
| (8) how well bottom plugged 4" cap | | | |
| DRILLERS REMARKS: | | | |


RECEIVED

JUN - 9 1978

MISS. BD. OF WATER COMM

If well telescopes please sketch and show depths.

GROUND LEVEL

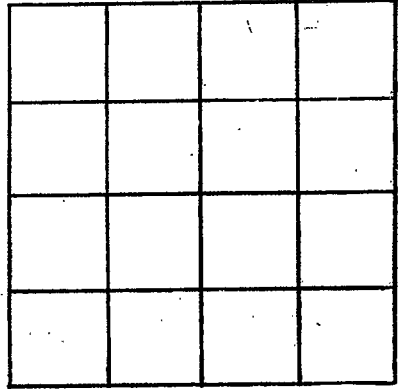

SECTION _____

Please indicate well location X.

ADDITIONAL INFORMATION

If more than one screen, show locations of each on sketch.