

MARSHALL
 G 200
 5-19-78

MISSISSIPPI
 BOARD OF WATER COMMISSIONERS
 416 North State Street
 Jackson, Mississippi 39201

WATER WELL DRILLERS LOG

May 19 1978 Bill R. Simpson MARSHALL
 date well completed firm name county well located

LANDOWNER:
HOWARD HAILEY
Holly Springs, Miss
 (mailing address)

WELL LOCATION:
 sec 26 T 2 N R 2 E
 S W
3 miles S of LAMAR
 (distance) (direction) (nearest town)

description of formations encountered	from	to
<u>SURFACE CLAY</u>	<u>0</u>	<u>15</u>
<u>COARSE SAND</u>	<u>15</u>	<u>135</u>
<u>WHITE CLAY</u>	<u>135</u>	<u>175</u>
<u>FINE SAND W. CLAY</u>	<u>175</u>	<u>200</u>
<u>MEG. SAND</u>	<u>200</u>	<u>214</u>

WELL PURPOSE: Home
 (home, irrigation, municipal, industrial)

WELL COMPLETION DATA:

(1) diameter (inches) 6

(2) total depth (feet) 214

(3) static water level (feet) 130 below top of ground.

(4) casing PCC 208
 (material) (depth)

_____ if telescope see back.
 (size)

(5) screen 6' 208
 (length) (depth to top)

4' GRAVEL PACKER
 (size) (material)

(6) pump 3/4 8
 (HP) (yield gpm)

Elec
 (type power)

(7) electric log No
 (yes or no)

_____ (organization running log)

(8) how well bottom plugged PCC
CAP


DRILLERS REMARKS:

RECEIVED
 JUN 19 1978

MISS. BD. OF WATER COMMISSIONERS

If well telescopes please sketch and show depths.

GROUND LEVEL

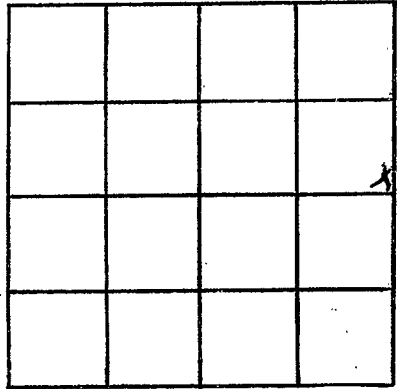

SECTION 26

Please indicate well location X.

ADDITIONAL INFORMATION

If more than one screen, show locations of each on sketch.