

MARSHALL
 G 212
 7-13-78

MISSISSIPPI
 BOARD OF WATER COMMISSIONERS
 416 North State Street
 Jackson, Mississippi 39201

WATER WELL DRILLERS LOG

7-13 1978 date well completed
 Dean Hett Builders firm name
 Marshall county well located

LANDOWNER:	description of formations encountered	from	to
(mailing address)			
Sammie Byson	Clay	0	20
Lamarina	Sand	20	50
	Clay	50	60
	Sand	60	135

LANDOWNER:

description of formations encountered

from

to

WELL LOCATION:


sec. 22 T 2 N R 3 E
 57 miles N.W. of Marshall
 (distance) (direction) (nearest town)

WELL PURPOSE: Drinking
 (home, irrigation, municipal, industrial)

WELL COMPLETION DATA:

- (1) diameter (inches) 4"
- (2) total depth (feet) 135 feet
- (3) static water level (feet) 55 below above top of ground.
- (4) casing PVC, 135 feet
 (material) (depth)
 (size) If telescope see back.
- (5) screen 24", 138 feet
 (length) (depth to top)
4", 2 sand wall
 (size) (material)
- (6) pump 3/4 14
 (HP) (yield gpm)
 (type power)
- (7) electric log flat
 (yes or no)
 (organization running log)
- (8) how well bottom plugged 4" cap.


DRILLERS REMARKS:

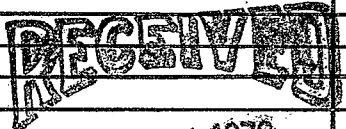

AUG 14 1978

If well telescopes please
sketch and show depths.

GROUND LEVEL

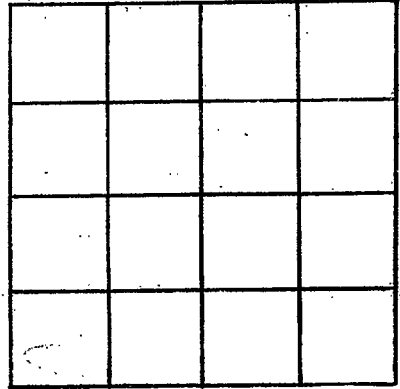

SECTION _____

Please indicate well location X.

ADDITIONAL INFORMATION

If more than one screen,
show locations of each on sketch.