

MARSHALL
 6 2013
 7-7-78

MISSISSIPPI
 BOARD OF WATER COMMISSIONERS
 416 North State Street
 Jackson, Mississippi 39201

WATER WELL DRILLERS LOG

7-7 1978 *R. Dean Kent Construction Marshall*
 date well completed firm name county well located

LANDOWNER:
Ezra Lyons
Leroy, Missi
 (mailing address)

description of formations encountered	from	to
<i>clay</i>	<i>0</i>	<i>20</i>
<i>sand</i>	<i>20</i>	<i>60</i>
<i>clay</i>	<i>60</i>	<i>80</i>
<i>sand</i>	<i>80</i>	<i>147</i>

WELL LOCATION:
 sec. *27* T. *2* N. R. *2* E.
S *W*
5.7 miles *N.W.* of *Hudsonville*
 (distance) (direction) (nearest town)

WELL PURPOSE: *Domestic*
 (home, irrigation, municipal, industrial)

- WELL COMPLETION DATA:
- (1) diameter (inches) *4"*
 - (2) total depth (feet) *147 feet*
 - (3) static water level (feet) *60* below above top of ground.
 - (4) casing *PVC* *147 feet*
 (material) (depth)
 (size) if telescope see back.
 - (5) screen *7 ft* *140 feet*
 (length) (depth to top)
11" *gravel well*
 (size) (material)
 - (6) pump *3/4* *14*
 (HP) (yield gpm)
 (type power)
 - (7) electric log *elect.*
 (yes or no)
 - (organization running log)
 - (8) how well bottom plugged *4" cap.*


DRILLERS REMARKS:
87 feet water
Good well
7 EC 210 - 120 feet

RECEIVED
 AUG 14 1978

MISS. BD. OF WATER COMM

If well telescopes please sketch and show depths.

GROUND LEVEL

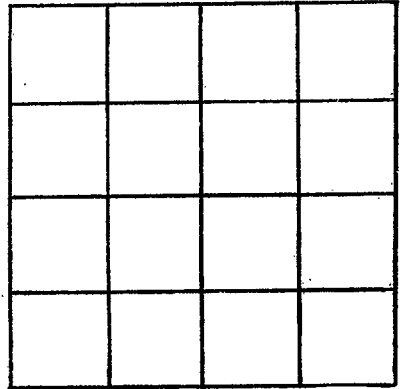

SECTION _____

Please indicate well location X.

ADDITIONAL INFORMATION

If more than one screen,
show locations of each on sketch.