

MARSHALL

G 214

9-26-78

MISSISSIPPI  
 BOARD OF WATER COMMISSIONERS  
 416 North State Street  
 Jackson, Mississippi 39201

WATER WELL DRILLERS LOG

9-26-1978 Hicks Well Co Marshall  
 date well completed firm name county well located

LANDOWNER: Kelley James

P.O. Box 199  
Holly Springs, Mn  
 (mailing address)

description of formations encountered

from to

Red Clay 0 40  
White Clay + Sand 40 120  
White Sand 120 145  
White Clay + Sand 145 175

WELL LOCATION:

sec 27 T 2 N R 2 E  
7 miles NE of Holly Springs  
 (distance) (direction) (nearest town)

WELL PURPOSE:

(home, irrigation, municipal, industrial) Home

WELL COMPLETION DATA:

- (1) diameter (inches) 4
- (2) total depth (feet) 175
- (3) static water level (feet) 125 below top of ground.
- (4) casing PVC 175  
 (material) (depth)

(size) if telescope see back.

- (5) screen 7' 188  
 (length) (depth to top)  
4" gravel type  
 (size) (material)

- (6) pump 3/4 10  
 (HP) (yield gpm)

220V  
(type power)

- (7) electric log No  
 (yes or no)

(organization running log)

- (8) how well bottom plugged Cep


DRILLERS REMARKS:

**RECEIVED**  
 OCT 30 1978

MISS. BD. OF WATER COMM.

If well telescopes please sketch and show depths.

GROUND LEVEL

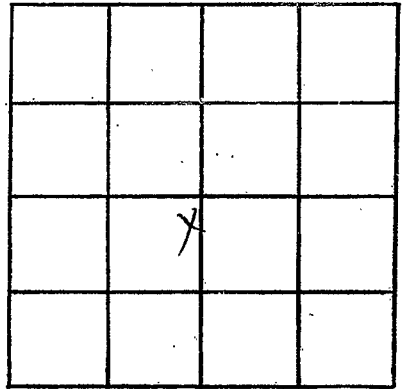

SECTION 27

Please indicate well location X.

ADDITIONAL INFORMATION

If more than one screen,  
show locations of each on sketch.