

MARSHALL

G 2015

9-27-78

MISSISSIPPI BOARD OF WATER COMMISSIONERS  
416 North State Street  
Jackson, Mississippi 39201

WATER WELL DRILLERS LOG

9-27-78 date well completed  
Hicks Well Co. firm name  
Marshall county well located

LANDOWNER: Stella McKay

description of formations encountered

from to

Plot

James, Ms. (mailing address)

Red Clay 0 10

Red Sand 10 25

WELL LOCATION:

sec. 35 T 2 N R 2 E  
1 miles N of Hattiesburg (distance) (direction) (nearest town)

Red Sand + Clay 25 50

White clay + sand 50 90

WELL PURPOSE: Home (home, irrigation, municipal, industrial)

White Sand 90 135

WELL COMPLETION DATA:

- (1) diameter (inches) 4
- (2) total depth (feet) 135
- (3) static water level (feet) 60 below top of ground.
- (4) casing PVC 125 (material) (depth)

(size) if telescope see back.

- (5) screen 7 128 (length) (depth to top)

4" gravel top (size) (material)

- (6) pump 1/2 10 (HP) (yield gpm)


220V (type power)

- (7) electric log No (yes or no)

(organization running log)

- (8) how well bottom plugged Cap


DRILLERS REMARKS:

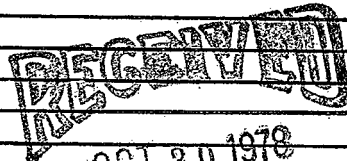

MISS. BD. OF WATER COMMISSIONERS

If well telescopes please sketch and show depths.

GROUND LEVEL

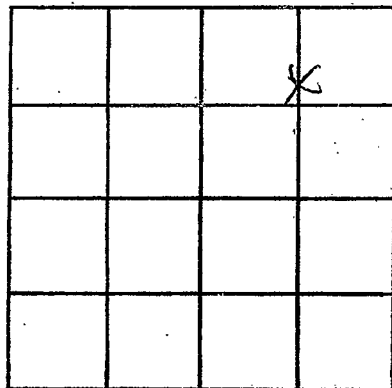

SECTION 35

Please indicate well location X.

ADDITIONAL INFORMATION

If more than one screen, show locations of each on sketch.