

MARSHALL

G 2016

12-14-76

MISSISSIPPI BOARD OF WATER COMMISSIONERS
416 North State Street
Jackson, Mississippi 39201

WATER WELL DRILLERS LOG

5

Dec 14 1976
date well completed

R. L. Carpenter
firm name

Marshall
county well located

LANDOWNER: Steve Hand

Lamar, Miss

Rt. 1

(mailing address)

WELL LOCATION:

sec. 5 T. 25 N. R. 2 E
S W
1/2 miles South of Slayden
(distance) (direction) (nearest town)

WELL PURPOSE: Home
(home, irrigation, municipal, industrial)

WELL COMPLETION DATA:

- (1) diameter (inches) 4
- (2) total depth (feet) 232
- (3) static water level (feet) 162 below above top of ground.
- (4) casing Plastic, 226'
(material) (depth)
(size) If telescope see back.
- (5) screen 6' 226'
(length) (depth to top)
4" Plastic & Hand
(size) (material)
- (6) pump 3/4 18
(HP) (yield gpm)
Elec.
(type power)
- (7) electric log no
(yes or no)

(organization running log)

(8) how well bottom plugged PVC Cap

DRILLERS REMARKS:

description of formations encountered

from

to

surface soil	0	18
med. Red sand	18	35
med. white sand	35	60
white clay	60	78
med. white sand	78	120
white coarse sand	120	180
white med. sand	180	232


Miss. Board of Water Comm.

MAR 12 1979

RECEIVED

If well telescopes please sketch and show depths.

GROUND LEVEL

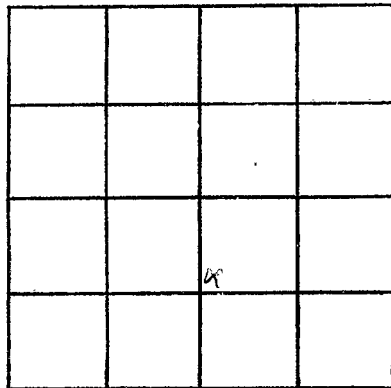

SECTION 5

Please indicate well location X.

ADDITIONAL INFORMATION

If more than one screen,
show locations of each on sketch.