

MARSHALL

G 2017

7-25-77

MISSISSIPPI
 BOARD OF WATER COMMISSIONERS
 416 North State Street
 Jackson, Mississippi 39201

WATER WELL DRILLERS LOG

July 25 19 77 R.L. Capesta Marshall
 date well completed firm name county well located

LANDOWNER: Kurt Yeager
Loma, Miss.
R.F.D.
 (mailing address)

description of formations encountered	from	to
Surface Soil	0	15
Med. Red Soil	15	38
Coarse White Soil	38	75
White Clay	75	110
Med. White Soil	110	160
White Coarse Soil	160	186

WELL LOCATION:
 sec. 5 T. 2 N R. 2 E
La Slayden, Miss
 (distance) miles (direction) of (nearest town)

WELL PURPOSE: None
 (home, irrigation, municipal, industrial)

- WELL COMPLETION DATA:
- (1) diameter (inches) 4
 - (2) total depth (feet) 186
 - (3) static water level (feet) 160 below above top of ground.
 - (4) casing Plastic, 176'
 (material) (depth)
 (size) if telescope see back.
 - (5) screen 10', 176'
 (length) (depth to top)
4", Plastic
 (size) (material)
 - (6) pump 3/4, 10
 (HP) (yield gpm)
9 hp
 (type power)
 - (7) electric log Yes
 (yes or no)
 - (organization running log)
 - (8) how well bottom plugged PVC Cap

DRILLERS REMARKS:


Miss. Board of Water Comm.

MAR 12 1979

RECEIVED

If well telescopes please sketch and show depths.

GROUND LEVEL

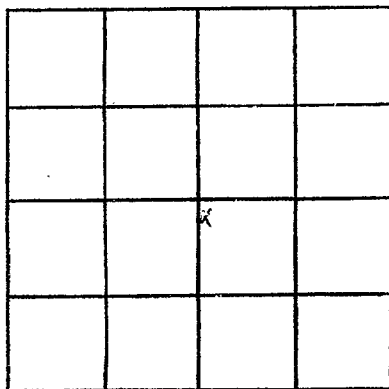

SECTION 5

Please indicate well location X.

ADDITIONAL INFORMATION

If more than one screen,
show locations of each on sketch.