

MARSHALL

G 2019

11-02-77

MISSISSIPPI BOARD OF WATER COMMISSIONERS
416 North State Street
Jackson, Mississippi 39201

WATER WELL DRILLERS LOG

Nov. 2 1977
date well completed

R. L. Carpenter
firm name

Marshall
county well located

LANDOWNER: S. P. Wagon

Loma, Miss

RFD

(mailing address)

description of formations encountered

from

to

Surface Soil 5 20

med Red sand 25 45

white clay 45 78

white coarse + med sand 78 148

white clay 148 148

white coarse sand 148 195

WELL LOCATION:

sec. 19 T-2 N R-2 E
S W
4 miles South of Sledge
(distance) (direction) (nearest town)

WELL PURPOSE: Home
(home, irrigation, municipal, industrial)

WELL COMPLETION DATA:

(1) diameter (inches) 4

(2) total depth (feet) 195

(3) static water level (feet) 132 below top of ground.

(4) casing Plastic, 185' (material) (depth)

(size) if telescope see back.

(5) screen 10' 185' (length) (depth to top)

4" Plastic (size) (material)

(6) pump 3/4 18 (HP) (yield gpm)

Elec. (type power)

(7) electric log No. (yes or no)

(organization running log)

(8) how well bottom plugged PVC Cap

DRILLERS REMARKS:


Miss. Board of Water Comm.

MAR 12 1979

RECEIVED

If well telescopes please
sketch and show depths.

GROUND LEVEL

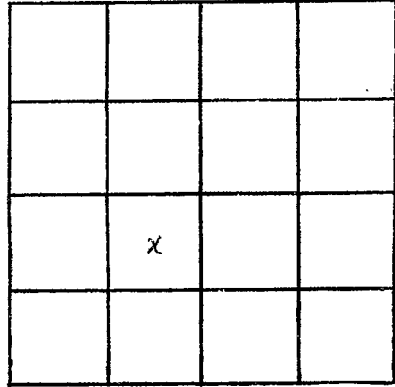

SECTION 19

Please indicate well location X.

ADDITIONAL INFORMATION

If more than one screen,
show locations of each on sketch.