

MARSHALL
G 2020

MISSISSIPPI
BOARD OF WATER COMMISSIONERS
416 North State Street
Jackson, Mississippi 39201

11/8/78
Nov. 8 1978

WATER WELL DRILLERS LOG

date well completed

firm name

county well located

R. L. Carpenter Marshall

LANDOWNER: Ormie Lee Jones
Lamar, Miss
RFD
(mailing address)

description of formations encountered

from

to

WELL LOCATION:
sec. 3 T 2 N R 2 E
2 1/2 miles East of Snyder
(distance) (direction) (nearest town)

Surface soil	0	16
red. Red sand	16	45
loose white sand	45	86
red white sand	86	130
white clay	130	148
white coarse sand	148	180

WELL PURPOSE: Home
(home, irrigation, municipal, industrial)

WELL COMPLETION DATA:

(1) diameter (inches) 4

(2) total depth (feet) 180

(3) static water level (feet) 115 below above top of ground.

(4) casing Plastic, 170'
(material) (depth)
(size) if telescope see back.

(5) screen 10', 170'
(length) (depth to top)
1/2", Plastic
(size) (material)

(6) pump 1/2 9
(HP) (yield gpm)
Elec.
(type power)

(7) electric log no
(yes or no)

(organization running log)

(8) how well bottom plugged Pvc Cap

DRILLERS REMARKS:


DEPT. OF NATURAL RESOURCES
BUREAU OF LAND & WATER RESOURCES

MAY 18 1981

RECEIVED

If well telescopes please sketch and show depths.

GROUND LEVEL

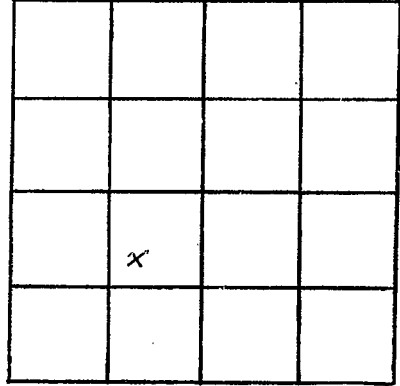

SECTION 3

Please indicate well location X.

ADDITIONAL INFORMATION

If more than one screen,
show locations of each on sketch.