

MARSHALL
G 2022

MISSISSIPPI
BOARD OF WATER COMMISSIONERS
416 North State Street
Jackson, Mississippi 39201

WATER WELL DRILLERS LOG

4/18/79
16-18
date well completed

M.D. Caperton
firm name

Marshall
county well located

LANDOWNER: Henry Mason
Lumberton, Miss.
R.F.D.
(mailing address)

description of formations encountered	depth	
	from	to
<u>Surface Soil</u>	<u>0</u>	<u>12</u>
<u>Med. Red Sand</u>	<u>12</u>	<u>28</u>
<u>Med White Sand</u>	<u>28</u>	<u>60</u>
<u>White Clay</u>	<u>60</u>	<u>67</u>
<u>White fine sand</u> <u>& white clay mixed</u>	<u>67</u>	<u>117</u>
<u>White coarse sand</u>	<u>117</u>	<u>164</u>

WELL LOCATION:
sec. 2 T. 2 N. R. 2 E.
S W
3 1/2 miles East of Sladen
(distance) (direction) (nearest town)

WELL PURPOSE: Home
(home, irrigation, municipal, industrial)

WELL COMPLETION DATA:

(1) diameter (inches) 4

(2) total depth (feet) 164

(3) static water level (feet) 95 below above top of ground.

(4) casing Plastic, 184'
(material) (depth)
(size) if telescope see back.

(5) screen 10", 154'
(length) (depth to top)
4, Plastic
(size) (material)

(6) pump 1/2, 9
(HP) (yield gpm)
Electric
(type power)

(7) electric log no.
(yes or no)
(organization running log)


(8) how well bottom plugged P.U.C. Co.

DRILLERS REMARKS:

DEPT. OF NATURAL RESOURCES
BUREAU OF LAND & WATER RESOURCES
MAY 18 1981
RECEIVED

If well telescopes please
sketch and show depths.

GROUND LEVEL

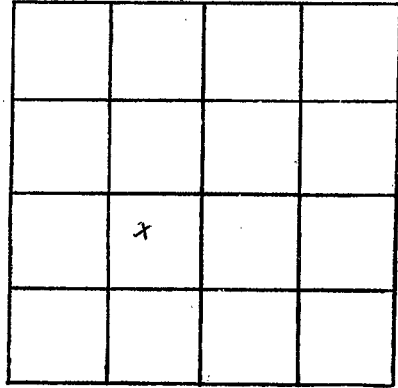

SECTION 2

Please indicate well location X.

ADDITIONAL INFORMATION

If more than one screen,
show locations of each on sketch.