

MARSHALL
G 223
5/15/79

MISSISSIPPI
BOARD OF WATER COMMISSIONERS
416 North State Street
Jackson, Mississippi 39201

WATER WELL DRILLERS LOG

May 15 19 79 P. L. Caputo Marshall
date well completed firm name county well located

LANDOWNER: Eddie Campbell
Lamar, Miss.
R. F. D.
(mailing address)

description of formations encountered	from to	
	from	to
<u>Surface Soil</u>	<u>0</u>	<u>16</u>
<u>Med Red Sand</u>	<u>16</u>	<u>44</u>
<u>Coarse White Sand</u>	<u>44</u>	<u>87</u>
<u>Med White Sand</u>	<u>87</u>	<u>130</u>
<u>White (Shaly)</u>	<u>130</u>	<u>147</u>
<u>White Coarse Sand</u>	<u>147</u>	<u>180</u>

WELL LOCATION:
sec. 3 T. 2 N R. 2 E
S W
1/2 miles East of Shaylen
(distance) (direction) (nearest town)


WELL PURPOSE: Water
(home, irrigation, municipal, industrial)

WELL COMPLETION DATA:
(1) diameter (inches) 4
(2) total depth (feet) 180
(3) static water level (feet) 115 below
top of ground.
(4) casing Plastic 1 7/8"
(material) (depth)
(size) if telescope see back.
(5) screen 16', 170'
(length) (depth to top)
4", Plastic
(size) (material)
(6) pump 1/2 9
(HP) (yield gpm)
Elec.
(type power)
(7) electric log no
(yes or no)
(organization running log)
(8) how well bottom plugged P.L. Caputo

DRILLERS REMARKS:

If well telescopes please sketch and show depths.

GROUND LEVEL

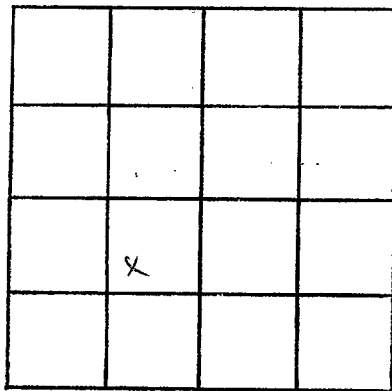

SECTION 3

Please indicate well location X.

ADDITIONAL INFORMATION

If more than one screen,
show locations of each on sketch.