

Marshall  
G 224

MISSISSIPPI  
BOARD OF WATER COMMISSIONERS  
416 North State Street  
Jackson, Mississippi 39201

WATER WELL DRILLERS LOG

7/9/79  
July 9 1979 R. L. Carpenter Marshall  
date well completed firm name county well located

LANDOWNER: Hardy Roy  
Laney, Miss.  
RFD  
(mailing address)

WELL LOCATION:  
sec. 20 T. 2 N R. 2 E  
3 1/2 miles South of Sloyden  
(distance) (direction) (nearest town)

WELL PURPOSE: Hay Barn  
(home, irrigation, municipal, industrial)

- WELL COMPLETION DATA:
- (1) diameter (inches) 4
  - (2) total depth (feet) 220
  - (3) static water level (feet) 150 below top of ground.
  - (4) casing Plastic, 200' (material) (depth)  
If telescope see back.  
(size)
  - (5) screen 20', 200' (length) (depth to top)  
4" Plastic (size) (material)
  - (6) pump 1 1/2 20 (HP) (yield gpm)  
Elev. (type power)
  - (7) electric log No. (yes or no)  
(organization running log)
  - (8) how well bottom plugged PVC Cap


description of formations encountered	from	to
Surface Soil	0	18
med. Red Sand	18	38
med white sand	38	65
white clay	65	78
med white sand	78	130
white coarse & fine sand	130	175
white coarse sand	175	220

DEPT. OF NATURAL RESOURCES  
BUREAU OF LAND & WATER RESOURCES  
MAY 18 1991  
RECEIVED

DRILLERS REMARKS:

If well telescopes please sketch and show depths.

GROUND LEVEL

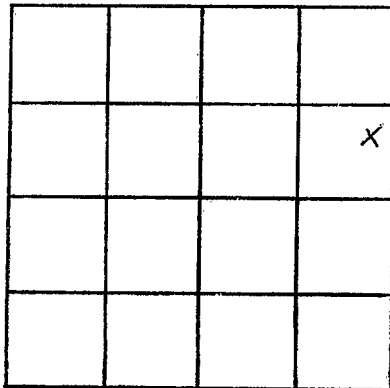

SECTION 20

Please indicate well location X.

ADDITIONAL INFORMATION

If more than one screen, show locations of each on sketch.