

MARSHALL

Facts

G 2025

5-11-79

5-10

19 79

Wicks Well Co

MARSHALL

Facts

MISSISSIPPI
BOARD OF WATER COMMISSIONERS
416 North State Street
Jackson, Mississippi 39201

WATER WELL DRILLERS LOG

date well completed

firm name

county well located

LANDOWNER:

Lucious Reynolds

Rt. 1, Box 104, Lumberton Miss.
(mailing address)

WELL LOCATION:

sec. 27 T. 2 N. R. 2 E
4 miles NW of Lumberton
(distance) (direction) (nearest town)

WELL PURPOSE: home
(home, irrigation, municipal, industrial)

WELL COMPLETION DATA:

- (1) diameter (inches) 4 in
- (2) total depth (feet) 155
- (3) static water level (feet) 120 below top of ground.
- (4) casing 155
(material) (depth)
- (size) if telescope see back.
- (5) screen 7ft 148ft
(length) (depth to top)
4 in Gravel
(size) (material)
- (6) pump 1/2 10
(HP) (yield gpm)
220
(type power)
- (7) electric log No
(yes or no)
- (organization running log)

(8) how well bottom plugged Cap

description of formations encountered

from

to

Red Clay	0	20
White Clay + Red Sand	20	70
Red sand	70	100
White sand	100	155

Miss. Board of Water Comm.


MAY 14 1979

DRILLERS REMARKS:

RECEIVED

If well telescopes please sketch and show depths.

GROUND LEVEL

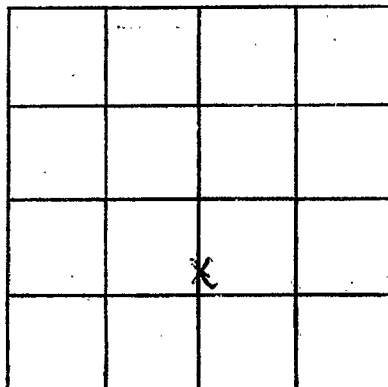

SECTION 27

Please indicate well location X.

ADDITIONAL INFORMATION

If more than one screen, show locations of each on sketch.