

date

Marshall
G 2026
6/1/99

MISSISSIPPI
BOARD OF WATER COMMISSIONERS
416 North State Street
Jackson, Mississippi 39201

WATER WELL DRILLERS LOG

date well completed 19 Atkinson + Frost Well Supply firm name Marshall county well located

LANDOWNER: Annie Ambrose

description of formations encountered

from to

Rt 5

Clay

0 20

Sand

20 95

Clay

95 105

Sand

105 160

Clay

160 170

Sand clay

170 210

Sand

210 240

Holly Springs Miss
(mailing address)

WELL LOCATION:

? sec. 2 T. 2 N. R. 2E
4 miles West of Nadsonville
(distance) (direction) (nearest town)

WELL PURPOSE:

(home, irrigation, municipal, industrial)

WELL COMPLETION DATA:

(1) diameter (inches) 4"

(2) total depth (feet) 240

(3) static water level (feet) 170 below above top of ground.

(4) casing PVC 230
(material) (depth)

4"
(size) if telescope see back.

(5) screen 10 240
(length) (depth to top)

6" PVC
(size) (material)

(6) pump _____
(HP) (yield gpm)

(type power)

(7) electric log _____
(yes or no)

(organization running log)

(8) how well bottom plugged _____

DRILLERS REMARKS:


Miss. Board of Water Commis

JUN 25 1999

RECEIVED

If well telescopes please sketch and show depths.

GROUND LEVEL

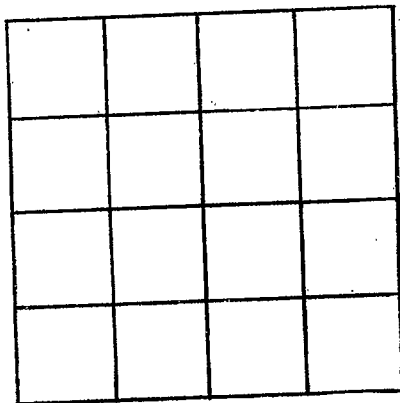

SECTION _____

Please indicate well location X.

ADDITIONAL INFORMATION

If more than one screen, show locations of each on sketch.