

MARSHALL
G 2027
5/15/79

12

MISSISSIPPI  
BOARD OF WATER COMMISSIONERS  
416 North State Street  
Jackson, Mississippi 39201

WATER WELL DRILLERS LOG

MAY 15 1979 Billy R. Simpson MARSHALL  
 date well completed                      firm name                      county well located

LANDOWNER: <u>J.W. COCKE No. 2</u> <u>Holly Springs MS</u> (mailing address)	description of formations encountered	from	to
	<u>Surface Chert</u> <u>SAND + WHITE CLAY</u> <u>WHITE CLAY</u> <u>SAND</u>	<u>0</u> <u>10</u> <u>110</u> <u>130</u>	<u>10</u> <u>110</u> <u>130</u> <u>150</u>

WELL LOCATION:  
 sec. 28 T. 2 N. R. 2 E.  
           S                      W  
5 miles S of SLYDEE  
 (distance)                      (direction)                      (nearest town)

WELL PURPOSE: Home  
 (home, irrigation, municipal, industrial)

WELL COMPLETION DATA:

(1) diameter (inches) 4

(2) total depth (feet) 153

(3) static water level (feet) 715 below above top of ground.

(4) casing POC 149  
 (material) (depth)

          If telescope see back.  
 (size)

(5) screen 6 149  
 (length) (depth to top)

4 GRAVEL PACKED  
 (size) (material)

(6) pump 3/4 10  
 (HP) (yield gpm)

Flec  
 (type power)

(7) electric log No  
 (yes or no)

(organization running log)

(8) how well bottom plugged POC  
CPP

DRILLERS REMARKS:


Miss. Board of Water Comm.

AUG 14 1979

RECEIVED

If well telescopes please sketch and show depths.

GROUND LEVEL

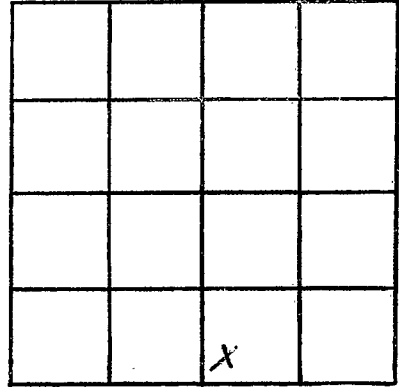

SECTION 280

Please indicate well location X.

ADDITIONAL INFORMATION

If more than one screen, show locations of each on sketch.