

| |
|----------|
| MARSHALL |
| G 2028 |
| 5/10/79 |

MISSISSIPPI
 BOARD OF WATER COMMISSIONERS
 416 North State Street
 Jackson, Mississippi 39201

WATER WELL DRILLERS LOG

May 10 1979 Billy R. Strapson MARSHALL
 date well completed firm name county well located

LANDOWNER:
J. W. COCKE No 1
Holly Springs MS
 (mailing address)

| description of formations encountered | from | to |
|---------------------------------------|-----------|------------|
| <u>SURFACE CLAY</u> | <u>0</u> | <u>10</u> |
| <u>SAND</u> | <u>10</u> | <u>28</u> |
| <u>YELLOW CLAY</u> | <u>28</u> | <u>40</u> |
| <u>SAND</u> | <u>40</u> | <u>162</u> |

WELL LOCATION:
 sec 26 T 2 R 2
 S' W
4 miles S of SLAYDEN
 (distance) (direction) (nearest town)

WELL PURPOSE: HOME
 (home, irrigation, municipal, industrial)

WELL COMPLETION DATA:

(1) diameter (inches) 40

(2) total depth (feet) 162

(3) static water level (feet) 121 below above top of ground.

(4) casing PVC 156
 (material) (depth)

(size) If telescope see back.

(5) screen 6 156
 (length) (depth to top)

4 GRAVEL PACKED
 (size) (material)

(6) pump 3/4 10
 (HP) (yield gpm)

Elec
 (type power)

(7) electric log No
 (yes or no)

(organization running log)

(8) how well bottom plugged PVC
CAP

DRILLERS REMARKS:


Miss Board of Water Comm.

AUG 14 1979

RECEIVED

If well telescopes please sketch and show depths.

GROUND LEVEL

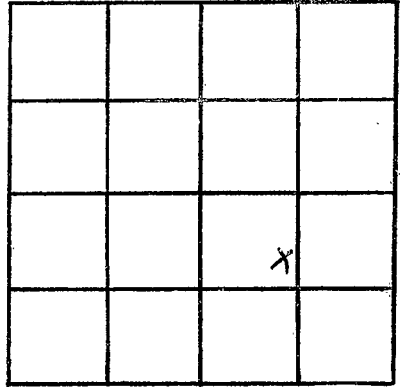

SECTION 20

Please indicate well location X.

ADDITIONAL INFORMATION

If more than one screen,
show locations of each on sketch.