

Marshall
 G 2029
 3-15-80

MISSISSIPPI
 BOARD OF WATER COMMISSIONERS
 416 North State Street
 Jackson, Mississippi 39201

WATER WELL DRILLERS LOG

MAR 15 1980 date well completed
 Billy R. Simpson firm name
 MARSHALL county well located

LANDOWNER:
 WAYNE SHAW
 LAMAR MS
 (mailing address)

description of formations encountered	from	to
SURFACE CLAY	0	10
SAND	10	155
WHITE CLAY	155	160
SAND	160	185
WHITE CLAY	185	186
MED SAND	186	205

WELL LOCATION:
 sec. 12 T 2 N R 2 E
 S W
 2 miles W of LAMAR
 (distance) (direction) (nearest town)

WELL PURPOSE: HOB PARLOR
 (home, irrigation, municipal, industrial)

- WELL COMPLETION DATA:
- diameter (inches) 4
 - total depth (feet) 205
 - static water level (feet) 144 below top of ground.
 - casing: pcc 195
 (material) (depth)
 (size) if telescope see back.
 - screen 10 195
 (length) (depth to top)
 4" pcc
 (size) (material)
 - pump 3/4 10
 (HP) (yield gpm)
 Elec
 (type power)
 - electric log No
 (yes or no)
 (organization running log)
 - how well bottom plugged pcc
 CAP

DEPT. OF NATURAL RESOURCES
 BUREAU OF LAND & WATER RESOURCES


APR 21 1980

RECEIVED

DRILLERS REMARKS:

If well telescopes please sketch and show depths.

GROUND LEVEL

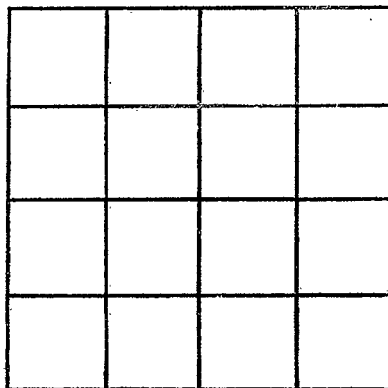

SECTION _____

Please indicate well location X.

ADDITIONAL INFORMATION

If more than one screen, show locations of each on sketch.