

Marshall

G 2030

4-15-78

4-15

1978 R. L. Carpenter

Marshall

date well completed

firm name

county well located

MISSISSIPPI
 BOARD OF WATER COMMISSIONERS
 416 North State Street
 Jackson, Mississippi 39201

WATER WELL DRILLERS LOG

LANDOWNER: Roger Kinke

Lamar, Miss

RFD

(mailing address)

WELL LOCATION:

sec. 13 T. 2 N R. 2 E
 5 miles Southeast of Sledge
 (distance) (direction) (nearest town)

WELL PURPOSE:

Home (home, irrigation, municipal, industrial)

WELL COMPLETION DATA:

- (1) diameter (inches) 4
- (2) total depth (feet) 170
- (3) static water level (feet) 126 below top of ground.
- (4) casing Plastic, 160' (material) (depth)
(size) if telescope see back.
- (5) screen 18' 160' (length) (depth to top)
4" Plastic (size) (material)
- (6) pump 3/4 10 (HP) (yield gpm)
Elev. (type power)
- (7) electric log No. (yes or no)
- (organization running log)
- (8) how well bottom plugged PVC cap

description of formations encountered	from	to
Surfow Soil	0	22
Med Red Sand	22	45
Red Coarse Sand	45	68
White Coarse Sand	68	110
White Fine Sand & white clay	110	135
White Coarse Sand	135	170

DRILLERS REMARKS:


DEPT. OF NATURAL RESOURCES
 BUREAU OF LAND & WATER RESOURCES

JUL 28 1980

RECEIVED

If well telescopes please sketch and show depths.

GROUND LEVEL

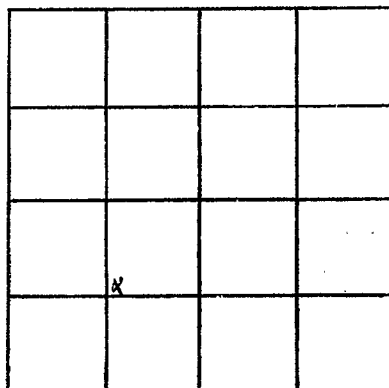

SECTION 13

Please indicate well location X.

ADDITIONAL INFORMATION

If more than one screen,
show locations of each on sketch.