

Marshall
G 2031
8/1/79

MISSISSIPPI
BOARD OF WATER COMMISSIONERS
416 North State Street
Jackson, Mississippi 39201

WATER WELL DRILLERS LOG

Aug. 1 1979 R. L. Coysante Marshall
date well completed firm name county well located

LANDOWNER: Willie Hanson

Lena, Miss

RFD

(mailing address)

WELL LOCATION:

sec. 7 T. 2 N. R. 2 E.
S. W.
2 miles South of Shyler
(distance) (direction) (nearest town)

WELL PURPOSE: Home
(home, irrigation, municipal, industrial)

WELL COMPLETION DATA:

- (1) diameter (inches) 4
- (2) total depth (feet) 185
- (3) static water level (feet) 100 below
top of ground.
- (4) casing PVC, 175'
(material) (depth)
(size) if telescope see back.
- (5) screen 16', 175'
(length) (depth to top)
4" PVC
(size) (material)
- (6) pump 1/2 9
(HP) (yield gpm)
2 hp.
(type power)
- (7) electric log No.
(yes or no)
(organization running log)
- (8) how well bottom plugged PVC Cap

description of formations
encountered

from

to

<u>Surface Soil</u>	<u>0</u>	<u>18</u>
<u>med red. Sand</u>	<u>18</u>	<u>45</u>
<u>med white Sand</u>	<u>45</u>	<u>90</u>
<u>white clay</u>	<u>90</u>	<u>120</u>
<u>med white s</u>		
<u>Fine Sand mixed</u>	<u>120</u>	<u>160</u>
<u>white coarse sand</u>	<u>160</u>	<u>185</u>

DRILLERS REMARKS:


MISSISSIPPI DEPARTMENT OF NATURAL RESOURCES
BUREAU OF LAND & WATER RESOURCES

MAY 18 1981

RECEIVED

If well telescopes please sketch and show depths.

GROUND LEVEL

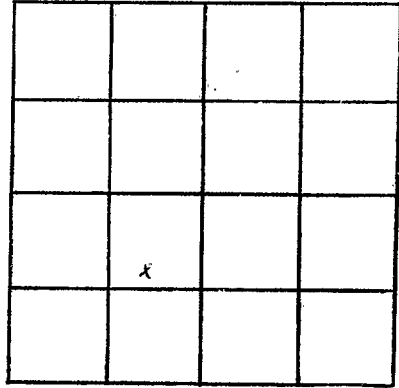

SECTION 2

Please indicate well location X.

ADDITIONAL INFORMATION

A series of horizontal lines for writing additional information, starting below the 'ADDITIONAL INFORMATION' header and extending to the bottom of the page.

If more than one screen, show locations of each on sketch.