

MISSISSIPPI DEPARTMENT OF NATURAL RESOURCES

Bureau of Land and Water Resources

Southport Mall

P.O. Box 10631

Jackson, Mississippi 39209

WATER WELL DRILLERS LOG

MARSHALL  
G 2033  
10-20-80

10-20 1980 Pam Hest Marshall  
 date well completed firm name county well located

LANDOWNER:  
J. B. Jones, Inc.  
Slayden, Miss.  
 (mailing address)

description of formations encountered	from	to
<u>clay</u>	<u>0</u>	<u>20</u>
<u>sand</u>	<u>20</u>	<u>210</u>

WELL LOCATION:  
 sec. 8 T. 2 N. R. 2 E.  
4 miles South of Slayden  
 (distance) (direction) (nearest town)

WELL PURPOSES Drilling  
 (home, irrigation, municipal, industrial)

WELL COMPLETION DATA:

(1) diameter (inches) 4"

(2) total depth (feet) 210 feet

(3) static water level (feet) 10 ft below above top of ground.

(4) casing PVC, 210 feet  
 (material) (depth)

       if telescope see back.  
 (size)

(5) screen 7 ft., 203  
 (length) (depth to top)

4", gravel  
 (size) (material)

(6) pump 1, 20  
 (HP) (yield gpm)

        
 (type power)

(7) electric log yes  
 (yes or no)

        
 (organization running log)

(8) how well bottom plugged 4" cap.

DRILLERS REMARKS:


DEPT. OF NATURAL RESOURCES  
 BUREAU OF LAND & WATER RESOURCES

NOV 12 1980

RECEIVED

If well telescopes please  
sketch and show depths.

GROUND LEVEL

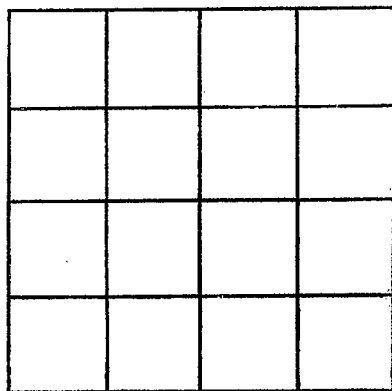

SECTION \_\_\_\_\_

Please indicate well location X.

ADDITIONAL INFORMATION

If more than one screen,  
show locations of each on sketch.