

MARSHALL  
G 235  
7/1/80

MISSISSIPPI  
BOARD OF WATER COMMISSIONERS  
416 North State Street  
Jackson, Mississippi 39201

WATER WELL DRILLERS LOG

July 1, 1980 Rod. Carpenter Marshall  
date well completed firm name county well located

LANDOWNER: Rodger Head  
Lamar, Miss.  
RFD  
(mailing address)

WELL LOCATION:  
sec. 6 T 2 N R 2 E  
S W  
1 miles South of Slouch  
(distance) (direction) (nearest town)

WELL PURPOSE: Home  
(home, irrigation, municipal, industrial)

- WELL COMPLETION DATA:
- diameter (inches) 4
  - total depth (feet) 210
  - static water level (feet) 95 below above top of ground.
  - casing Plastic, 200'  
(material) (depth)  
(size) if telescope see back.
  - screen 10' 200'  
(length) (depth to top)  
1/2" Plastic  
(size) (material)
  - pump 1/2 10  
(HP) (yield gpm)  
Elans  
(type power)
  - electric log no  
(yes or no)  
(organization running log)
  - how well bottom plugged PVC Cap


description of formations encountered	from	to
Surface Soil	0	20
Red Sand	20	45
Med White Sand	45	90
White Clay	90	130
Med White Sand	130	180
Coarse Sand	180	210

DRILLERS REMARKS:

DEPT OF NATURAL RESOURCES  
BUREAU OF LAND & WATER  
MAY 10 1981  
RECEIVED

If well telescopes please sketch and show depths.

GROUND LEVEL

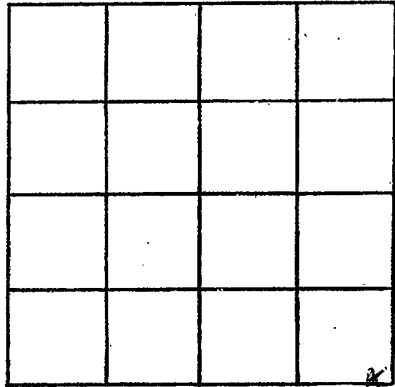

SECTION 6

Please indicate well location X.

ADDITIONAL INFORMATION

If more than one screen, show locations of each on sketch.