

Marshall
G 2039
2/15/81
Feb. 75

MISSISSIPPI
BOARD OF WATER COMMISSIONERS
416 North State Street
Jackson, Mississippi 39201

WATER WELL DRILLERS LOG


date well completed

firm name

county well located

19 81 R. L. Carpenter Marshall

LANDOWNER: <i>Kimmer Walker Lamar, Miss</i>	description of formations encountered	from	to
<i>RFD</i> (mailing address)	<i>Surfsoil</i>	0	20
WELL LOCATION: sec. <i>10</i> T. <i>2</i> N. R. <i>2</i> E S. W.	<i>Med. Red Sand</i>	20	46
<i>3</i> miles <i>S.E.</i> of <i>Shafter</i> (distance) (direction) (nearest town)	<i>Med. of Sand White Sand</i>	46	80
WELL PURPOSE: <i>Home</i> (home, irrigation, municipal, industrial)	<i>white clay</i>	80	92
WELL COMPLETION DATA: (1) diameter (inches) <i>14</i>	<i>white fine sand</i>	92	125
(2) total depth (feet) <i>145</i>	<i>white coarse sand</i>	125	145
(3) static water level (feet) <i>120</i> below top of ground.			
(4) casing <i>PVC</i> <i>135'</i> (material) (depth)			
(size) if telescope see back.			
(5) screen <i>10'</i> <i>135'</i> (length) (depth to top)			
<i>4"</i> <i>PVC</i> (size) (material)			
(6) pump <i>1/2</i> <i>9</i> (HP) (yield gpm)			
<i>3 hp</i> (type power)			
(7) electric log <i>yes</i> (yes or no)			
(organization running log)			
(8) how well bottom plugged <i>PVC Cap</i>			
DRILLERS REMARKS:			

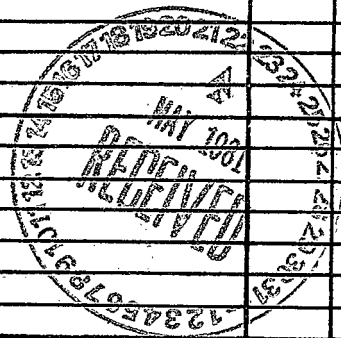

If well telescopes please sketch and show depths.

GROUND LEVEL

		X	

SECTION 10

Please indicate well location X.

ADDITIONAL INFORMATION

If more than one screen, show locations of each on sketch.