

MARSHALL  
G 240  
2/20/81  
Feb 20

MISSISSIPPI  
BOARD OF WATER COMMISSIONERS  
416 North State Street  
Jackson, Mississippi 39201

WATER WELL DRILLERS LOG

date well completed

firm name

county well located

19 81 R.L. Carpenter Marshall

LANDOWNER:

Christine Fitzpatrick

description of formations encountered

from

to

Loman, Miss

Surface Soil

0

18

RFD

med. Red Sand

18

48

(mailing address)

WELL LOCATION:

sec. 10 T 2 N R 2 E S W

med. white Sand

48

95

3 miles SE of Snyder (distance) (direction) (nearest town)

white clay

75

88

WELL PURPOSE:

None

(home, irrigation, municipal, industrial)

white fine sand

88

120

WELL COMPLETION DATA:

white coarse sand

120

144

(1) diameter (inches)

4

(2) total depth (feet)

144

(3) static water level (feet) above top of ground.

110

(4) casing

PVC 134'

(material) (depth)

(size) if telescope see back.

(5) screen

10' 134'

(length) (depth to top)

2" PVC (size) (material)

(6) pump

1/2 9

(HP) (yield gpm)

Elec. (type power)

(7) electric log


No (yes or no)

(organization running log)

(8) how well bottom plugged


PVC caps

DRILLERS REMARKS:

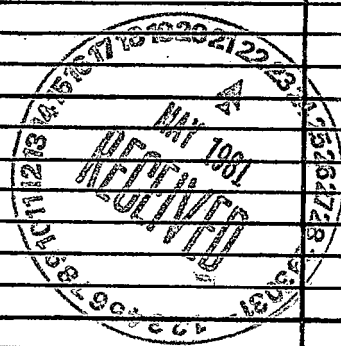

If well telescopes please sketch and show depths.

GROUND LEVEL

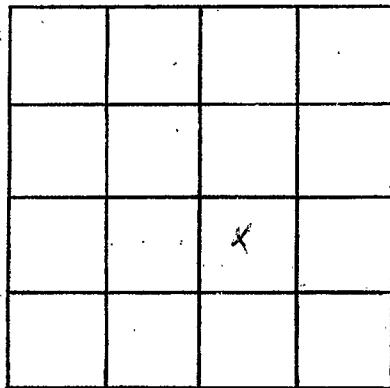

SECTION 10

Please indicate well location X.

ADDITIONAL INFORMATION

If more than one screen, show locations of each on sketch.