

Marshall
G 2041
3/10/81

MISSISSIPPI
BOARD OF WATER COMMISSIONERS
416 North State Street
Jackson, Mississippi 39201

WATER WELL DRILLERS LOG

3-10 1981 R. L. Carpenter Marshall
date well completed firm name county well located


LANDOWNER: Clyde Campbell
Lamar, Miss
RFD
(mailing address)

WELL LOCATION:
sec. 27 T 2 N R 2 E
S W
2 miles East of Albany
(distance) (direction) (nearest town)

WELL PURPOSE: Home
(home, irrigation, municipal, industrial)

- WELL COMPLETION DATA:
- (1) diameter (inches) 4
 - (2) total depth (feet) 200
 - (3) static water level (feet) 140 below top of ground.
 - (4) casing PVC, 190' (material) (depth)
(size) if telescope see back.
 - (5) screen 10' 190' (length) (depth to top)
(size) (material)
 - (6) pump 3/4 12 (HP) (yield gpm)
Elev.
(type power)
 - (7) electric log No. (yes or no)
(organization running log)
 - (8) how well bottom plugged PVC Cap


description of fomations encountered	from	to
Surface Soil	0	17
Med. Red Soil	17	30
Med. White Soil & White Clay	30	78
Med. White Soil	78	120
White Clay	120	135
White coarse Sand	135	200

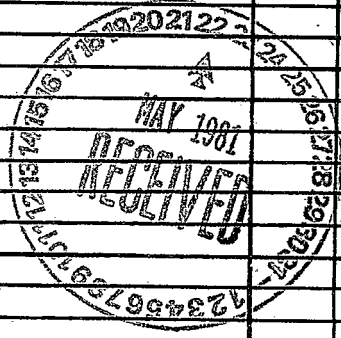

DRILLERS REMARKS:

If well telescopes please sketch and show depths.

GROUND LEVEL

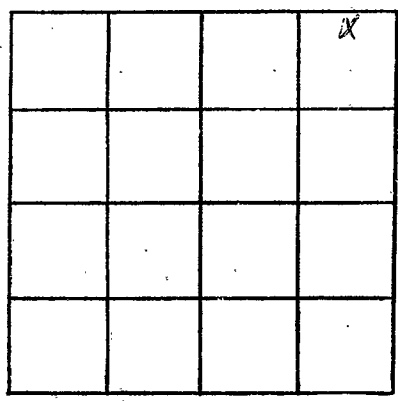

SECTION 27

Please indicate well location X.

ADDITIONAL INFORMATION

A series of horizontal lines for recording additional information.

If more than one screen, show locations of each on sketch.