

MARSHALL  
G 2042  
3/16/81  
Mar. 16

MISSISSIPPI  
BOARD OF WATER COMMISSIONERS  
416 North State Street  
Jackson, Mississippi 39201

WATER WELL DRILLERS LOG

date well completed

firm name

county well located

1981 R.H. Carpenter Marshall

LANDOWNER: D.W. Payne

Laney, Miss

RFD

(mailing address)

WELL LOCATION:

sec. 15 T 2 N R 2 E  
3 miles S.E. of Sledge  
(distance) (direction) (nearest town)

WELL PURPOSE: Home  
(home, irrigation, municipal, industrial)

WELL COMPLETION DATA:


- (1) diameter (inches) 4
- (2) total depth (feet) 140
- (3) static water level (feet) 111 below top of ground.
- (4) casing PVC 130' (material) (depth)  
(size) if telescope see back.
- (5) screen 10' 130' (length) (depth to top)  
4" PVC (size) (material)
- (6) pump 1/2 9 (HP) (yield gpm)  
Elex (type power)
- (7) electric log no (yes or no)
- (organization running log)
- (8) how well bottom plugged PVC cap

description of formations encountered

from

to


Surface Soil	0	15
med. & coarse Red Sand	15	40
med. white Sand	40	67
white clay & fine Sand	67	85
white med. Sand	85	120
white coarse Sand	120	140

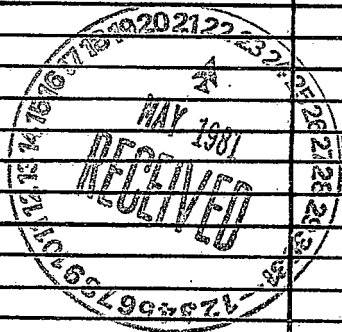

DRILLERS REMARKS:

If well telescopes please  
sketch and show depths.

GROUND LEVEL

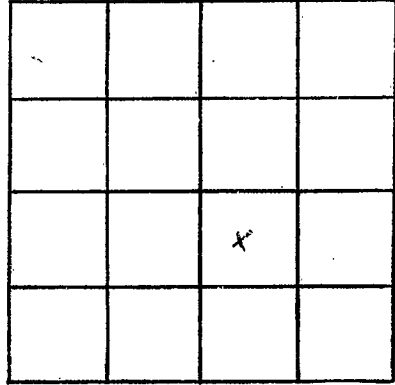

SECTION 10

Please indicate well location X.

ADDITIONAL INFORMATION

If more than one screen,  
show locations of each on sketch.