

MARSHALL

G 2043

3/25/81

March 25, 1981

MISSISSIPPI
 BOARD OF WATER COMMISSIONERS
 416 North State Street
 Jackson, Mississippi 39201

WATER WELL DRILLERS LOG

date well completed

firm name

county well located

R. L. Carpenter

Marshall

LANDOWNER:

Charles Stevens

Laney, Miss.

R.F.O.

(mailing address)

WELL LOCATION:

sec. 7 T. 2 N. R. 2 E
 S W
2 miles South of Shogden
 (distance) (direction) (nearest town)

WELL PURPOSE:

(home, irrigation, municipal, industrial)

None

WELL COMPLETION DATA:

- (1) diameter (inches) 4
- (2) total depth (feet) 130
- (3) static water level (feet) 90 below above top of ground.
- (4) casing PVC 120'
 (material) (depth)
 (size) if telescope see back.
- (5) screen 10' 120'
 (length) (depth to top)
10" PVC
 (size) (material)
- (6) pump 1/2 9
 (HP) (yield gpm)
2 hp.
 (type power)
- (7) electric log No
 (yes or no)
- (organization running log)
- (8) how well bottom plugged PVC Cap

description of formations encountered

from

to

Surface Soil

0

20

med. Red Sand

20

48

med. white sand

48

90

white clay


90

100

white coarse sand

100


130

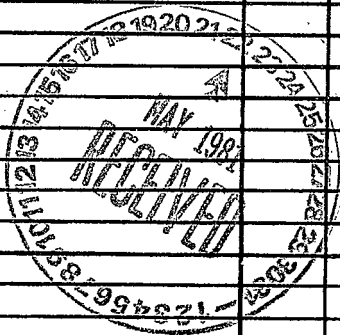

DRILLERS REMARKS:

If well telescopes please sketch and show depths.

GROUND LEVEL

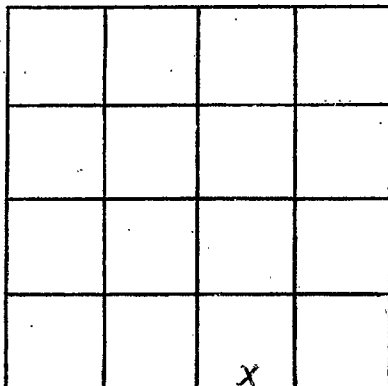

SECTION 7

Please indicate well location X.

ADDITIONAL INFORMATION

If more than one screen, show locations of each on sketch.