

MISSISSIPPI DEPARTMENT OF NATURAL RESOURCES

Bureau of Land and Water Resources

Southport Mall

P.O. Box 10631

Jackson, Mississippi 39209

WATER WELL DRILLERS LOG

Marshall
G 2045
6-15-82

6-15-82
 date well completed

Wilson Well Co
 firm name

Marshall
 county well located

LANDOWNER:
Orange Snow
Rt 2
Holly Springs, Miss
 (mailing address)

description of formations encountered	from	to
<u>Red clay - Red Sand</u>	<u>0</u>	<u>30</u>
<u>Red Sand</u>	<u>30</u>	<u>90</u>
<u>Red Sand - Blue clay</u>	<u>90</u>	<u>105</u>
<u>Blue clay - White sand</u>	<u>105</u>	<u>120</u>
<u>White Sand</u>	<u>120</u>	<u>150</u>

WELL LOCATION:
 sec 21 T 2 N R 2 E
4 miles S of St. Anna
 (distance) (direction) (nearest town)

WELL PURPOSE: home
 (home, irrigation, municipal, industrial)

- WELL COMPLETION DATA:
- (1) diameter (inches) 4
 - (2) total depth (feet) 150
 - (3) static water level (feet) 100' below top of ground.
 - (4) casing Plastic, (material) (depth) 4" (size) if telescope see back.
 - (5) screen 10 (length), (depth to top) 4" (size), PLASTIC (material)
 - (6) pump 3/4 (HP), 8 (yield gpm)
electric (type power)
 - (7) electric log NO (yes or no)

(organization running log)
 (8) how well bottom plugged Plastic Cap 4"

DRILLERS REMARKS:


DEPT. OF NATURAL RESOURCES
 BUREAU OF LAND & WATER RESOURCES

SEP - 9 1982

RECEIVED

If well telescopes please sketch and show depths.

GROUND LEVEL

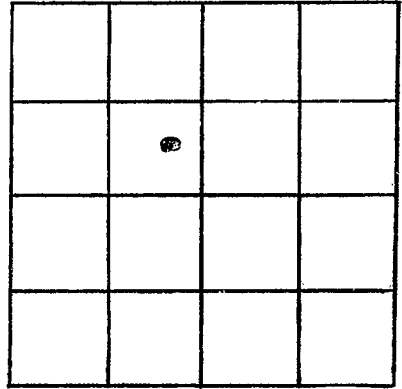

SECTION 21

Please indicate well location X.

ADDITIONAL INFORMATION

If more than one screen,
show locations of each on sketch.