

MARSHALL
G
2048

MISSISSIPPI DEPARTMENT OF NATURAL RESOURCES
 Bureau of Land and Water Resources
 Southport Mall
 P.O. Box 10631
 Jackson, Mississippi 39209
WATER WELL DRILLERS LOG

4-16 1983 Maewen Blomster well 6 Marshall
 date well completed firm name county well located

LANDOWNER: Ricky Taylor
Rt 2 Box 106 A
Holly Springs, Miss
 (mailing address)

| description of formations encountered | depth | |
|---------------------------------------|-----------|------------|
| | from | to |
| <u>Red Sand</u> | <u>0</u> | <u>35</u> |
| <u>White Sand</u> | <u>35</u> | <u>115</u> |

WELL LOCATION:
 sec. 26 T. 2 N. R. 2 E.
1/2 miles N of Hudsonville
 (distance) (direction) (nearest town)

WELL PURPOSE:
 (home) Irrigation, municipal, industrial

- WELL COMPLETION DATA:
- diameter (inches) 4
 - total depth (feet) 115
 - static water level (feet) 85 below above top of ground.
 - casing Plastic, 105 (material) (depth)
4 (size) If telescope see back.
 - screen 10, 105 (length) (depth to top)
4 (size) Plastic slotted (material)
 - pump 1/2, 10 (HP) (yield gpm)
Electric (type power)
 - electric log (yes or no)

(organization running log)
 (8) how well bottom plugged 4
Plastic Cap

DRILLERS REMARKS:


DEPT. OF NATURAL RESOURCES
 BUREAU OF LAND & WATER RESOURCES

MAY 6 - 1983

RECEIVED

If well telescopes please sketch and show depths.

GROUND LEVEL

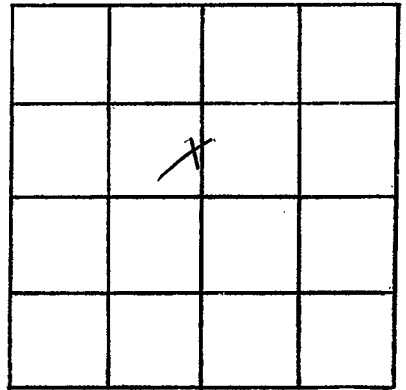

SECTION 26

Please indicate well location X.

ADDITIONAL INFORMATION

If more than one screen,
show locations of each on sketch.