

MISSISSIPPI DEPARTMENT OF NATURAL RESOURCES

Bureau of Land and Water Resources

Southport Mall

P.O. Box 10631

Jackson, Mississippi 39209

WATER WELL DRILLERS LOG

HICKS WELL CO.

Box 157

Senatobia, MS 38668

Marshall
G
2049

Marshall

8-18 19 83
date well completed

county well located

LANDOWNER: Jessy Thompson
Box 212
Lamar, Miss. 38642
(mailing address)

description of fomations encountered	from	to
Red clay	0	15
Red sand	15	30
White sand	30	140

WELL LOCATION:
sec. 12 T. 2 N. R. 2 E
3 miles (distance) (direction) of Lamar (nearest town)

WELL PURPOSE: Home
(home, irrigation, municipal, industrial)

WELL COMPLETION DATA:

(1) diameter (inches) 4"

(2) total depth (feet) 140'

(3) static water level (feet) 100 below top of ground.

(4) casing PVC, 140' (material), (depth)
4" (size) if telescope see back.

(5) screen 10, 130 (length), (depth to top)
1013, PVC (size), (material)

(6) pump 3/4, 10 (HP), (yield gpm)
220 (type power)

(7) electric log No (yes or no)
(organization running log)

(8) how well bottom plugged Cap

DRILLERS REMARKS:


DEPT. OF NATURAL RESOURCES
BUREAU OF LAND & WATER RESOURCES

SEP 22 1983

RECEIVED

If well telescopes please sketch and show depths.

GROUND LEVEL

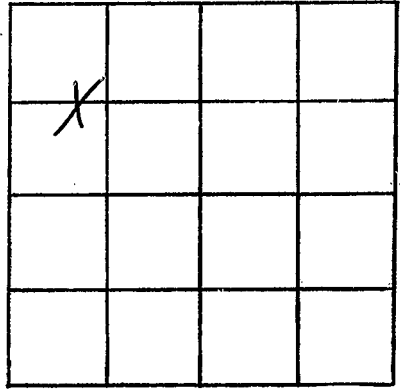

SECTION 12

Please indicate well location X.

ADDITIONAL INFORMATION

If more than one screen, show locations of each on sketch.