

MISSISSIPPI DEPARTMENT OF NATURAL RESOURCES  
 Bureau of Land and Water Resources  
 Southport Mall  
 P.O. Box 10631  
 Jackson, Mississippi 39209  
**WATER WELL DRILLERS LOG**

Marshall  
G  
2050

8-30 19 83 Wilson Well Co. Inc. Marshall  
 date well completed firm name county well located

LANDOWNER: Virginia Clayton  
5544 Shields  
Chicago, Ill.  
 (mailing address)

description of formations encountered	from	to
<u>Brown Clay</u>	<u>0</u>	<u>30</u>
<u>Brown Sand</u>	<u>30</u>	<u>120</u>
<u>White Sand</u>	<u>120</u>	<u>150</u>

WELL LOCATION:  
 sec. 18 T. 2 N. R. 2 E.  
3 miles S of Slayden  
 (distance) (direction) (nearest town)

WELL PURPOSE:  
 (home, irrigation, municipal, industrial)

WELL COMPLETION DATA:

(1) diameter (inches) 4

(2) total depth (feet) ~~150~~ 150

(3) static water level (feet) 140 below above top of ground.

(4) casing plastic, 150,  
 (material) (depth)  
4 If telescope see back.  
 (size)

(5) screen ~~10~~ 10,  
 (length) (depth to top)  
4, plastic  
 (size) (material)

(6) pump 3/4 8  
 (HP) (yield gpm)  
Electric  
 (type power)

(7) electric log NO  
 (yes or no)  
 (organization running log)

(8) how well bottom plugged 4"  
plastic cap

DRILLERS REMARKS:


DEPT. OF NATURAL RESOURCES  
 BUREAU OF LAND & WATER RESOURCES

SEP 19 1983

RECEIVED

If well telescopes please sketch and show depths.

GROUND LEVEL

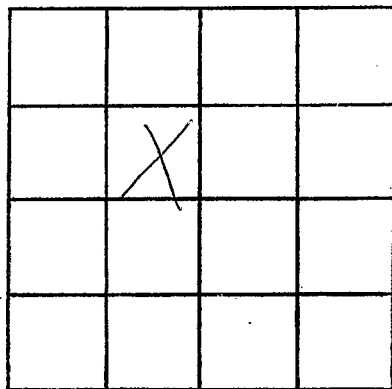

SECTION 18

Please indicate well location X.

ADDITIONAL INFORMATION

If more than one screen, show locations of each on sketch.