

MISSISSIPPI DEPARTMENT OF NATURAL RESOURCES

Bureau of Land and Water Resources

Southport Mall

P.O. Box 10631

Jackson, Mississippi 39209

WATER WELL DRILLERS LOG

HICKS WELL CO.

Rt. 1, Box 157

Senatobia, MS 38668

Marshall
G
2051

4/5 1984
date well completed

Marshall
county well located

LANDOWNER: *R.C. Skelton*
Ref. 2
Holly Springs, Ms. 38635
(mailing address)

description of formations encountered	from	to
<i>Red clay</i>	<i>0</i>	<i>10</i>
<i>Red sand</i>	<i>10</i>	<i>80</i>
<i>White sand</i>	<i>80</i>	<i>230</i>

WELL LOCATION:
sec. 13 T 2 N R 2 E
3 miles N of Huttonville
(distance) (direction) (nearest town)

WELL PURPOSE: *Home*
(home, irrigation, municipal, industrial)

- WELL COMPLETION DATA:
- (1) diameter (inches) 4
 - (2) total depth (feet) 230
 - (3) static water level (feet) 95 ^{below} above top of ground.
 - (4) casing PVC, 230,
(material) (depth)
4" if telescope see back.
(size)
 - (5) screen 10', 220
(length) (depth to top)
1010, PVC
(size) (material)
 - (6) pump 1, 10
(HP) (yield gpm)
220V
(type power)
 - (7) electric log No
(yes or no)
 - (organization running log)
 - (8) how well bottom plugged Cap

DRILLERS REMARKS:


DEPT. OF NATURAL RESOURCES
BUREAU OF LAND & WATER RESOURCES

APR 16 1984

RECEIVED

If well telescopes please sketch and show depths.

GROUND LEVEL

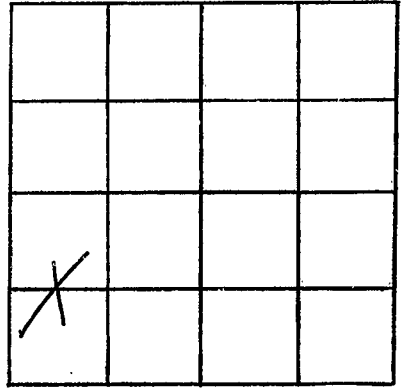

SECTION 13

Please indicate well location X.

ADDITIONAL INFORMATION

If more than one screen,
show locations of each on sketch.