

MISSISSIPPI DEPARTMENT OF NATURAL RESOURCES

Bureau of Land and Water Resources

Southport Mall

P.O. Box 10631

Jackson, Mississippi 39209

WATER WELL DRILLERS LOG

Marshall  
G  
2052

HICKS WELL CO.  
P.O. Box 157  
Senatobia, MS 38668

Marshall  
county well located

4/2 19 84  
date well completed

LANDOWNER: Mollie Cothran  
Pt. 1 Box 204  
Lamar, Ms. 38642  
(mailing address)

description of formations encountered	from	to
<u>Red clay</u>	<u>0</u>	<u>10</u>
<u>Red sand</u>	<u>10</u>	<u>80</u>
<u>White sand</u>	<u>80</u>	<u>230</u>

WELL LOCATION:  
sec. 23 T 2 N R 2 E  
2 1/2 miles N of Huttonville  
(distance) (direction) (nearest town)

WELL PURPOSE: Home  
(home, irrigation, municipal, industrial)

- WELL COMPLETION DATA:
- (1) diameter (inches) 4
  - (2) total depth (feet) 230
  - (3) static water level (feet) 180 <sup>below</sup> above top of ground.
  - (4) casing PVC, 230  
(material) (depth)  
4" if telescope see back.  
(size)
  - (5) screen 10, 220  
(length) (depth to top)  
.010, PVC  
(size) (material)
  - (6) pump 1, 10  
(HP) (yield gpm)  
220V  
(type power)
  - (7) electric log No  
(yes or no)
  - (organization running log)
  - (8) how well bottom plugged Cap

DRILLERS REMARKS:


DEPT. OF NATURAL RESOURCES  
BUREAU OF LAND & WATER RESOURCES

APR 16 1984

RECEIVED

If well telescopes please sketch and show depths.

GROUND LEVEL

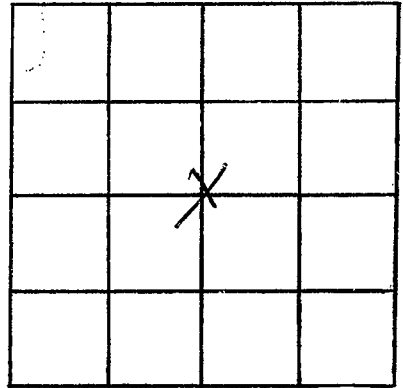

SECTION 23

Please indicate well location X.

ADDITIONAL INFORMATION

If more than one screen,  
show locations of each on sketch.