

MISSISSIPPI DEPARTMENT OF NATURAL RESOURCES

Bureau of Land and Water Resources

Southport Mall

P.O. Box 10631

Jackson, Mississippi 39209

WATER WELL DRILLERS LOG

G
2054

3-7 19 85 date well completed      HICKS WELL CO. firm name      Marshall county well located

LANDOWNER: <u>Annie Bell Phillips</u>	description of formations encountered	from	to
<u>Box 1</u>			
<u>James M.</u> (mailing address)	<u>Red Clay</u>	<u>0</u>	<u>10</u>
	<u>Red sand</u>	<u>10</u>	<u>30</u>
	<u>White sand</u>	<u>30</u>	<u>140</u>

WELL LOCATION:  
 sec. 35 T 2 N R 2 E  
1 miles N of Hartsville  
 (distance) (direction) (nearest town)

WELL PURPOSE: Home  
 (home, irrigation, municipal, industrial)

WELL COMPLETION DATA:

(1) diameter (inches) 4

(2) total depth (feet) 140

(3) static water level (feet) 150 <sup>below</sup> <sub>above</sub> top of ground.

(4) casing PVC, 140,  
 (material) (depth)  
4" if telescope see back.  
 (size)


(5) screen 10', 130  
 (length) (depth to top)  
3/16, PVC  
 (size) (material)

(6) pump 1/2, 10  
 (HP) (yield gpm)  
220V  
 (type power)

(7) electric log no  
 (yes or no)  
 (organization running log)


(8) how well bottom plugged Cap

DRILLERS REMARKS:

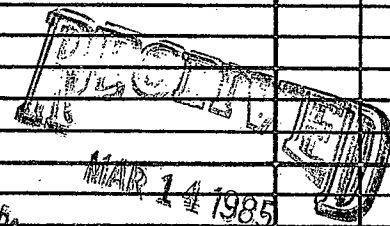

If well telescopes please sketch and show depths.

GROUND LEVEL

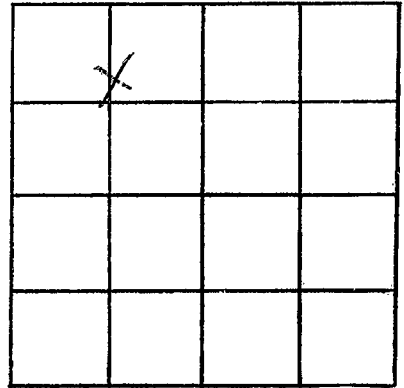

SECTION 35

Please indicate well location X.

ADDITIONAL INFORMATION

If more than one screen,  
show locations of each on sketch.