

MISSISSIPPI DEPARTMENT OF NATURAL RESOURCES

Bureau of Land and Water Resources

Southport Mall

P.O. Box 10631

Jackson, Mississippi 39209

WATER WELL DRILLERS LOG

Marshall
G
2055

5-9 1986 Green House Wells Marshall  
 date well completed firm name county well located


LANDOWNER: Bessie Valawone  
Rt 1 Box 144  
Lamar, Ms. 38642  
 (mailing address)

description of formations encountered	depth	
	from	to
<u>Brown Clay</u>	<u>0</u>	<u>15</u>
<u>Red Sand</u>	<u>15</u>	<u>60</u>
<u>White Sand</u>	<u>60</u>	<u>230</u>

WELL LOCATION:  
 sec. 5 T-2 N R-2 E  
1/2 miles S of Shoals  
 (distance) (direction) (nearest town)

WELL PURPOSE:  
 (home, irrigation, municipal, industrial)


- WELL COMPLETION DATA:
- (1) diameter (inches) 4
  - (2) total depth (feet) 230
  - (3) static water level (feet) 180 below above top of ground.
  - (4) casing Plastic 220  
 (material) (depth)  
 (size) if telescope see back.
  - (5) screen 10 220  
 (length) (depth to top)  
4 Plastic  
 (size) (material)
  - (6) pump 3/4 10  
 (HP) (yield gpm)  
Electric  
 (type power)
  - (7) electric log (yes or no) no  
 (organization running log)
  - (8) how well bottom plugged Plastic Cap

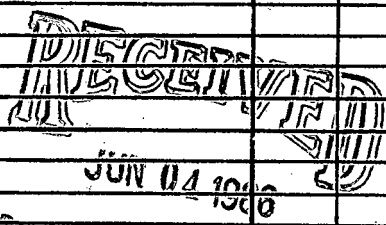

DRILLERS REMARKS:

If well telescopes please sketch and show depths.

GROUND LEVEL

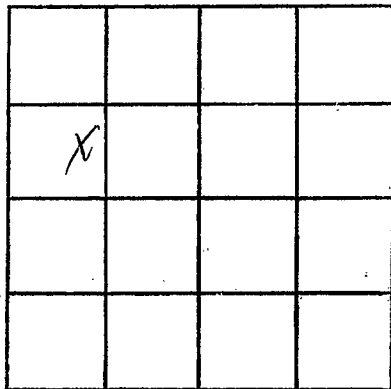

SECTION 5

Please indicate well location X.

ADDITIONAL INFORMATION

If more than one screen, show locations of each on sketch.