

MISSISSIPPI DEPARTMENT OF NATURAL RESOURCES

Bureau of Land and Water Resources

Southport Mall

P.O. Box 10631

Jackson, Mississippi 39209

WATER WELL DRILLERS LOG

MARSHALL
G
2056

4-29
date well completed

1985 Larry Carpenter Well Co
firm name

Marshall
county well located

LANDOWNER: Jeanine Ross
Loma, ms.

(mailing address)

WELL LOCATION:

sec. 6 T 2 N R 2 E
S W
3/4 miles South of Slayden
(distance) (direction) (nearest town)

WELL PURPOSE: Home
(home, irrigation, municipal, industrial)

WELL COMPLETION DATA:

- (1) diameter (inches) 4
- (2) total depth (feet) 175
- (3) static water level (feet) 135 below top of ground.
- (4) casing PVC, 165'
(material) (depth)
 if telescope see back.
(size)
- (5) screen 10', 165'
(length) (depth to top)
4in, PVC
(size) (material)
- (6) pump 3/4, 12
(HP) (yield gpm)
Electric
(type power)
- (7) electric log no
(yes or no)


(organization running log)

(8) how well bottom plugged PVC cap

description of formations encountered

from to

Surface Soil	0	20
med. & coarse Red Sand	20	55
White coarse Sand	55	90
White Clay	90	108
med. white Sand	108	130
White coarse Sand	130	175

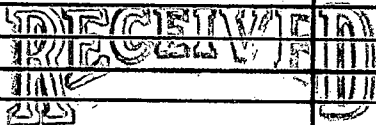


JUL 23 1986

Department of Natural Resources
Bureau of Land & Water Resources

DRILLERS REMARKS:

If well telescopes please
sketch and show depths.

GROUND LEVEL

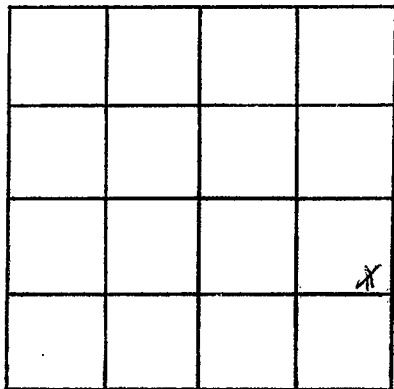

SECTION 6

Please indicate well location X.

ADDITIONAL INFORMATION

If more than one screen,
show locations of each on sketch.