

MISSISSIPPI DEPARTMENT OF NATURAL RESOURCES

Bureau of Land and Water Resources

Southport Mall

P.O. Box 10631

Jackson, Mississippi 39209

WATER WELL DRILLERS LOG

MARSHALL
G
2057

11-14 1985 Larry Carpenter Well Co. Marshall
 date well completed firm name county well located

LANDOWNER: Margaret Turner
Lamar, Ms.
RFD
 (mailing address)

WELL LOCATION:
 sec. 7 T 2 N R 2 E
 S W
2 miles South of Sloyder
 (distance) (direction) (nearest town)

WELL PURPOSE: Home
 (home, irrigation, municipal, industrial)

WELL COMPLETION DATA:

(1) diameter (inches) 4

(2) total depth (feet) 160

(3) static water level (feet) 98 below above top of ground.

(4) casing PVC, 150'
 (material) (depth)
 (size) if telescope see back.

(5) screen 10', 150'
 (length) (depth to top)
4", PVC
 (size) (material)

(6) pump 3/4, 12
 (HP) (yield gpm)
Elec
 (type power)

(7) electric log no
 (yes or no)
 (organization running log)

(8) how well bottom plugged PVC cap

description of formations encountered	from	to
<u>Surface Soil</u>	<u>0</u>	<u>15</u>
<u>Med. Red Sand</u>	<u>15</u>	<u>40</u>
<u>Med. White Sand</u>	<u>40</u>	<u>78</u>
<u>White Clay</u>	<u>78</u>	<u>110</u>
<u>White Fine Sand</u>	<u>110</u>	<u>135</u>
<u>White Coarse Sand</u>	<u>135</u>	<u>160</u>

RECEIVED


JUL 23 1986

Department of Natural Resources
 Bureau of Land & Water Resources

DRILLERS REMARKS:

If well telescopes please
sketch and show depths.

GROUND LEVEL

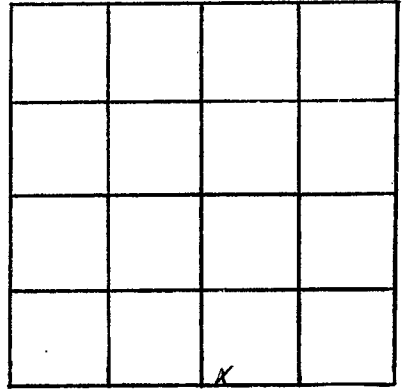

SECTION 2

Please indicate well location X.

ADDITIONAL INFORMATION

If more than one screen,
show locations of each on sketch.