

Marshall
H 2
10-1-68

MISSISSIPPI
BOARD OF WATER COMMISSIONERS
416 North State Street
Jackson, Mississippi 39201

CODED
CODED
CODED

WATER WELL DRILLERS LOG

10-1 1968 Harris Bros Marshall
date well completed firm name county well located

LANDOWNER: Robert Burks
Rto 1
Byhalia
(mailing address)

description of formations encountered	from	to
top soil	0	15
red sand	15	30
sand + clay	30	105
coarse sand	105	120

WELL LOCATION:
sec 23 T 3 N R 5 E
5 miles S of Byhalia
(distance) (direction) (nearest town)

WELL PURPOSE: Home
(home, irrigation, municipal, industrial)

WELL COMPLETION DATA:

(1) diameter (inches) 4
(2) total depth (feet) 120
(3) static water level (feet) 80 (below above) top of ground.
(4) casing Plastic, 113
(material) (depth)
4" if telescope see back.
(size)
(5) screen 7' , 113
(length) (depth to top)
008 , Plastic
(size) (material)
(6) pump 3/4 7
(HP) (yield gpm)
elec.
(type power)
(7) electric log No
(yes or no)
(organization running log)

CODED

(8) how well bottom plugged back
shot


JAN 21 1969

DRILLERS REMARKS:

MISS. BD. OF
WATER COMM.

If well telescopes please sketch and show depths.

GROUND LEVEL

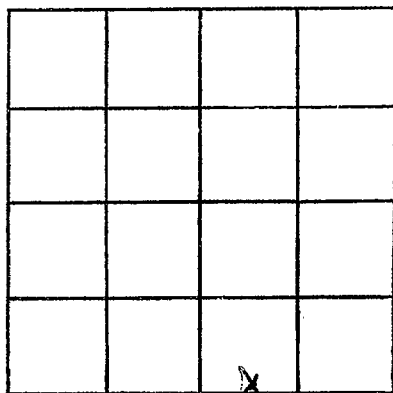

SECTION 23

Please indicate well location X.

ADDITIONAL INFORMATION

If more than one screen,
show locations of each on sketch.