

Marshall  
H3  
9-2-68

MISSISSIPPI  
BOARD OF WATER COMMISSIONERS  
416 North State Street  
Jackson, Mississippi 39201

CODED  
CODED

CODED

WATER WELL DRILLERS LOG

9-2 1968 Harris Bros Marshall  
date well completed firm name county well located

LANDOWNER: James S. Thompson  
P.O. Box 1 Byhalia  
(mailing address)

description of fomations encountered	from	to
top soil	0	15
red sand	15	30
clay + sand	30	100
colored sand	100	120

WELL LOCATION:  
sec 23 T 3 N R 5 E  
5 miles S of Byhalia  
(distance) (direction) (nearest town)

WELL PURPOSE: none  
(home, irrigation, municipal, industrial)

WELL COMPLETION DATA:

(1) diameter (inches) 4

(2) total depth (feet) 120

(3) static water level (feet) 80 <sup>below</sup>/<sub>above</sub> top of ground.

(4) casing Plastic 113 (material) (depth)  
4" (size) if telescope see back.

(5) screen 7' (length), 113 (depth to top)  
#8 Plastic (size) (material)

(6) pump 3/4 (HP), 7 (yield gpm)  
elec (type power)

(7) electric log no (yes or no)

(organization running log)

CODED

(8) how well bottom plugged. much  
short


JAN 21 1969

DRILLERS REMARKS:

MISS. BD. OF  
WATER COMM.

If well telescopes please sketch and show depths.

GROUND LEVEL

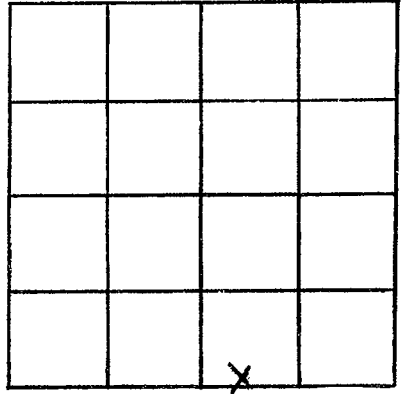

SECTION 23

Please indicate well location X.

ADDITIONAL INFORMATION

If more than one screen,  
show locations of each on sketch.