

15E

CODED

CODED

CODED

MISSISSIPPI BOARD OF WATER COMMISSIONERS
416 North State Street
Jackson, Mississippi 39201

MARSHALL
H4

9-24-68

WATER WELL DRILLERS LOG

9-24 1968
date well completed

W.A. Keim & Frost
firm name

Marshall
county well located

LANDOWNER:

Moody M C / Georgey

(mailing address)

description of formations encountered

from to

| | | |
|------------|-----|-----|
| Red Clay | 0 | 15 |
| Red Sand | 15 | 80 |
| White Clay | 80 | 100 |
| White Sand | 100 | 118 |

WELL LOCATION:

sec. 3 T. 3 N. R. 5 E
3 miles S.W. of Epahou
(distance) (direction) (nearest town)

WELL PURPOSE:

(home, irrigation, municipal, industrial)

WELL COMPLETION DATA:

- (1) diameter (inches) 4 1/2
- (2) total depth (feet) 118
- (3) static water level (feet) 95 below above top of ground.

(4) casing (material) (depth)

(size) If telescope see back.

(5) screen 10ft (length) (depth to top)

(size) (material)

(6) pump 1/2 (HP) 10 (yield gpm)

Elec (type power)

(7) electric log No (yes or no)

(organization running log)

(8) how well bottom plugged

CODED


JAN 27 1969

CLASS. FILED ON MAR 27 1969

DRILLERS REMARKS:

If well telescopes please sketch and show depths.

GROUND LEVEL

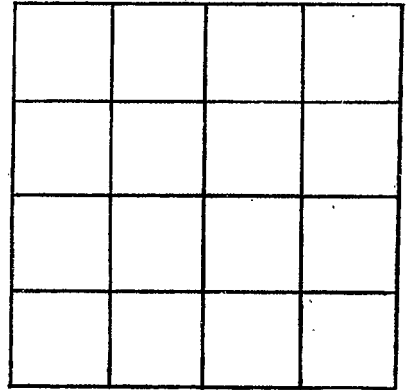

SECTION _____

Please indicate well location X.

ADDITIONAL INFORMATION

If more than one screen,
show locations of each on sketch.