

MARSHALL

H 7

1-11-69

MISSISSIPPI  
 BOARD OF WATER COMMISSIONERS  
 416 North State Street  
 Jackson, Mississippi 39201

CODED  
**CODED**  
 CODED

WATER WELL DRILLERS LOG

Jan 11 1969 Dempsey Wells Co Marshall  
 date well completed firm name county well located

LANDOWNER:

Glenn A. Lester  
R#2 Republica Miss  
 (mailing address)

description of formations encountered

Clay  
Sand

from to

0 45  
45 140

WELL LOCATION:

sec. 23 T. 3 N. R. 5 E  
<sup>S. 3/4</sup> <sub>W</sub>  
2 miles North of Wesson  
 (distance) (direction) (nearest town)

WELL PURPOSE:

(home, irrigation, municipal, industrial)

WELL COMPLETION DATA:

- (1) diameter (inches) 4
- (2) total depth (feet) 140
- (3) static water level (feet) 80 <sup>below</sup> <sub>above</sub> top of ground:
- (4) casing PVC 128  
 (material) (depth)  
4 if telescope see back.  
 (size)
- (5) screen 8" 138  
 (length) (depth to top)  
4" plastic-gravel  
 (size) (material)
- (6) pump 3/4 10  
 (HP) (yield gpm)  
Electric  
 (type power)
- (7) electric log                       
 (yes or no)
- (organization running log)

**CODED**

FEB 17 1969


MISS. DD. 25  
 WATER COMM.

(8) how well bottom plugged 4" PVC plug

DRILLERS REMARKS:

If well telescopes please  
sketch and show depths.

GROUND LEVEL

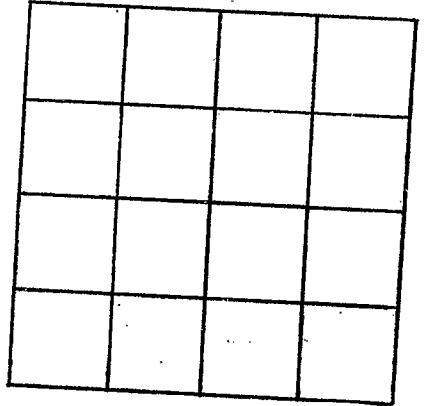

SECTION \_\_\_\_\_

Please indicate well location X.

ADDITIONAL INFORMATION

If more than one screen,  
show locations of each on sketch.