

Marshall
 HB
 2-15-69

MISSISSIPPI
 BOARD OF WATER COMMISSIONERS
 416 North State Street
 Jackson, Mississippi 39201

CODED

WATER WELL DRILLERS LOG

2-15-1969 Atkinson & Frost Marshall
 date well completed firm name county well located

LANDOWNER: L. AUCIOUS
~~Wilson~~
B. B. Wilson
 (mailing address)

description of formations encountered	from	to
Red clay	0	15
Red sand	15	60
white sand clay	60	70
white sand	70	130

WELL LOCATION:
 sec. 3 T. 3 N. R. 5 E
 $1\frac{1}{2}$ miles S of B. B. Wilson
 (distance) (direction) (nearest town)

WELL PURPOSE: home
 (home, irrigation, municipal, industrial)

- WELL COMPLETION DATA:
- (1) diameter (inches) 4"
 - (2) total depth (feet) 130
 - (3) static water level (feet) 95 below above top of ground.
 - (4) casing P.V.C. 120
 (material) (depth)
 (size) if telescope see back.
 - (5) screen 10 120
 (length) (depth to top)
4" P.V.C. Rockwell
 (size) (material)
 - (6) pump 1/2 10
 (HP) (yield gpm)
elec.
 (type power)
 - (7) electric log (yes or no)
 (organization running log)
 - (8) how well bottom plugged 4" CAP.

CODED

CODED


MAR 7 9 1969

MISS. BD. OF WATER COMMISSIONERS

DRILLERS REMARKS:

If well telescopes please sketch and show depths.

GROUND LEVEL

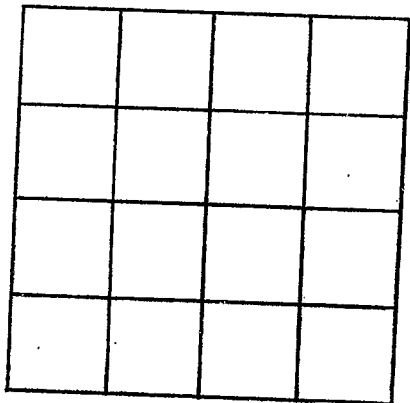

SECTION 3

Please indicate well location X.

ADDITIONAL INFORMATION

Lined area for additional information, consisting of approximately 20 horizontal lines.

If more than one screen, show locations of each on sketch.