

CODED

CODED

MISSISSIPPI BOARD OF WATER COMMISSIONERS
416 North State Street
Jackson, Mississippi 39201

Marshall
H 9
4 - 69

WATER WELL DRILLERS LOG

April 26 1969 Bumpas Wells Co Marshall
date well completed firm name county well located

LANDOWNER:

Robert Stalling
Dyhalia Miss
(mailing address)

description of formations encountered

from to

Clay Sand 0 15
15 120

WELL LOCATION:

sec. 14 T 3 N R 5 E
1 mill miles East of Winnaw
(distance) (direction) (nearest town)

WELL PURPOSE:

(home, irrigation, municipal, industrial)

WELL COMPLETION DATA:

- (1) diameter (inches) 4"
- (2) total depth (feet) 120
- (3) static water level (feet) 80 below above top of ground.
- (4) casing 4" 113
(material) (depth)
- (size) If telescope see back.
- (5) screen 7 1/2 113
(length) (depth to top)
- 4" gravel wall
(size) (material)
- (6) pump 3/4 20
(HP) (yield gpm)
- Elect
(type power)
- (7) electric log _____
(yes or no)
- _____ (organization running log)
- (8) how well bottom plugged 4" plug

CODED


AUG 4 1969

MISS. BD. OF WATER COMM.

DRILLERS REMARKS:

If well telescopes please
sketch and show depths.

GROUND LEVEL

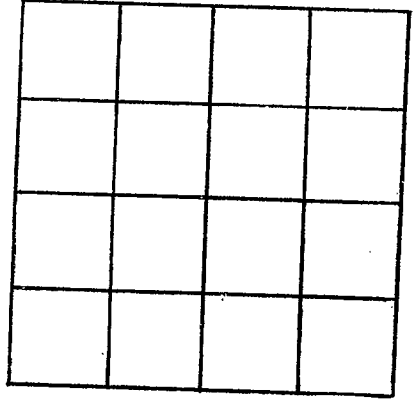

SECTION _____

Please indicate well location X.

ADDITIONAL INFORMATION

If more than one screen,
show locations of each on sketch.