

MISSISSIPPI  
BOARD OF WATER COMMISSIONERS  
416 North State Street  
Jackson, Mississippi 39201

**CODED**

Marshall  
H 10  
9-10-69

**WATER WELL DRILLERS LOG**

September 10th, 1969, W.A. Mason, Water Well Contractor  
date well completed 19 69 firm name Marshall county well located Marshall

LANDOWNER: Mrs. Blanche Ingram  
P.O. BOX, Bynalia Miss.

(mailing address)

WELL LOCATION:  
sec 26 T 3 N R 5 E  
W Woods corner  
miles 1/4 of (direction) (nearest town)  
(distance) (direction) (nearest town)  
Forest house

WELL PURPOSE:  
(home, irrigation, municipal, industrial)  
Water

**WELL COMPLETION DATA:**

- (1) diameter (inches) 12 inch hole
- (2) total depth (feet) 70
- (3) static water level (feet) 48 below top of ground. above
- (4) casing (material) 5 in styrene plastic (depth) 70 ft
- \_\_\_\_\_ If telescope see back. (size) none
- (5) screen (length) \_\_\_\_\_ (depth to top) \_\_\_\_\_ (size) \_\_\_\_\_ (material) none
- (6) pump (HP) \_\_\_\_\_ (yield gpm) \_\_\_\_\_ (type power) \_\_\_\_\_
- (7) electric log (yes or no) \_\_\_\_\_ (organization running log) \_\_\_\_\_
- (8) how well bottom plugged Not

description of formations encountered	from	to
Hard clay dirt	0	8
gravel	8	9
red gummy sand	9	20
yellow sand	20	22
yellow sand & gravel	22	28
black sand	28	50
white sand	50	55
loose, cavy orange sand	55	57
sandy white sand	57	57
sticky white sand	57	45
white pipe clay	45	47
white sand	47	48
water bearing sand (White, fine)	48	60
stagnant sand	60	70
that cleaned fast as water came through it		


DRILLERS REMARKS:

CGT 9-10-69

MISS. BD. OF WATER COMMISSIONERS

If well telescopes please sketch and show depths.

GROUND LEVEL

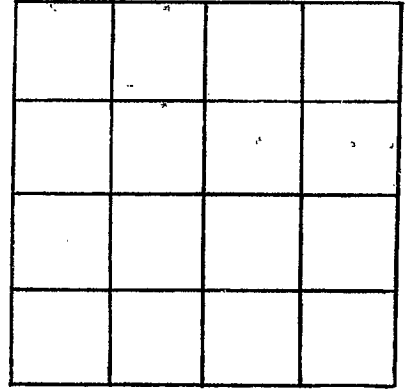

SECTION 26

Please indicate well location X.

ADDITIONAL INFORMATION

~~Old square well case well~~  
~~made by me in Nov. 1941~~  
~~older well made by Dock~~  
~~Mason approximately 20 yrs.~~

If more than one screen,  
show locations of each on sketch.