

ReCon Job

CODED

Marshall
H U.
10-8-69

MISSISSIPPI
BOARD OF WATER COMMISSIONERS
416 North State Street
Jackson, Mississippi 39201

WATER WELL DRILLERS LOG

October 8th - 1969 W.A. Mason - Water Well Contractor Marshall Co.
date well completed firm name county well located

LANDOWNER: Loreen Thompson
Route - 2
Byhalia Miss.
(mailing address)

description of formations encountered from to
White Course water
Graining sand 45 47

WELL LOCATION:
sec. 12 T. 3 N. R. 5 E.
1/2 miles East of 309 Hwy
(distance) (direction) (nearest town)
1/2 miles S. Byhalia

WELL PURPOSE: Home
(home, irrigation, municipal, industrial)

WELL COMPLETION DATA:

- (1) diameter (inches) 4"
- (2) total depth (feet) 47 FT.
- (3) static water level (feet) 35 below top of ground
- (4) casing (material) 4" Styrene Plastic (depth) 47 FT.
- 4" (size) if telescope see back.
- (5) screen none (length) (depth to top)
- (size) (material)
- (6) pump none (HP) (yield gpm)
- (type power)
- (7) electric log no (yes or no)
- (organization running log)
- (8) how well bottom plugged NOT

CODED


OCT 13 1969
MISS. BD. OF WATER COMM

DRILLERS REMARKS:

If well telescopes please sketch and show depths.

Labor -
Lewis Jones
Alvin Thomas
William Thomas

GROUND LEVEL

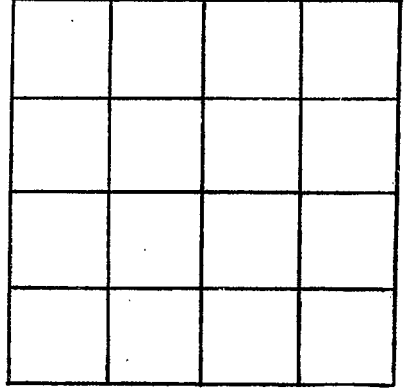

SECTION 12

Please indicate well location X.

ADDITIONAL INFORMATION

PVT #11 - STYRENE CASING
inside old 10 pc. 2"
Round wood casing
& pumped down abt.
two feet -

old well made by
FRANK SHIPP 1945

If more than one screen,
show locations of each on sketch.