

Marshall  
H 15,  
10-22-69

MISSISSIPPI  
 BOARD OF WATER COMMISSIONERS  
 416 North State Street  
 Jackson, Mississippi 39201

**CODED**

WATER WELL DRILLERS LOG

10-22 1969 Harris Bros Marshall  
 date well completed firm name county well located

LANDOWNER: W.B. Perkins  
Rt. 2  
Byhalia  
 (mailing address)

description of formations encountered	from	to
<u>top soil</u>	<u>0</u>	<u>20</u>
<u>clay + sand</u>	<u>20</u>	<u>90</u>
<u>fine sand</u>	<u>90</u>	<u>125</u>
<u>coarse sand</u>	<u>125</u>	<u>140</u>

WELL LOCATION:  
 sec. 12 T 3 N R 5 E  
8 miles N of Watson  
 (distance) (direction) (nearest town)

WELL PURPOSE: home  
 (home, irrigation, municipal, industrial)

- WELL COMPLETION DATA:
- (1) diameter (inches) 4"
  - (2) total depth (feet) 140
  - (3) static water level (feet) 90 below above top of ground.
  - (4) casing: Plastic, 133'  
 (material) (depth)  
4" if telescope see back.  
 (size)
  - (5) screen 7', 133'  
 (length) (depth to top)  
008 Plastic  
 (size) (material)
  - (6) pump 3/4, 10  
 (HP) (yield gpm)  
elec.  
 (type power)
  - (7) electric log no  
 (yes or no)

**CODED**

(organization running log)

(8) how well bottom plugged back  
shot


DRILLERS REMARKS:

DEC 29 1969

MISS. Bd. OF  
 WATER COMMISSIONERS

If well telescopes please sketch and show depths.

GROUND LEVEL

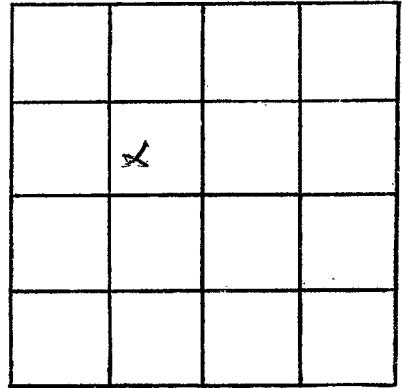

SECTION 12

Please indicate well location X.

ADDITIONAL INFORMATION

If more than one screen,  
show locations of each on sketch.