

RECURB

Marshall  
H16  
1-2-70

MISSISSIPPI  
BOARD OF WATER COMMISSIONERS  
416 North State Street  
Jackson, Mississippi 39201

CODED  
**CODED**

WATER WELL DRILLERS LOG

W. A. Mason

~~Jan. 2~~ Jan. 2 - 1970 To water well contractor Marshall Co.  
date well completed firm name county well located

LANDOWNER: A. N. French  
By halia Missi  
38611  
(mailing address)

description of formations encountered from to  
coarse white water bearing sand 57 60

WELL LOCATION:  
sec. 15 T 3 N R 5 E  
1 3/4 miles WEST of WINNAP  
(distance) (direction) (nearest town)

WELL PURPOSE: TENANT HOUSE  
(home, irrigation, municipal, industrial)  
cane stalk

- WELL COMPLETION DATA:
- (1) diameter (inches) 4"
  - (2) total depth (feet) 60 Feet
  - (3) static water level (feet) 50 below top of ground.
  - (4) casing PVC plastic 60 Feet (material) (depth)  
4" (size) if telescope see back.
  - (5) screen none (length) (depth to top)  
(size) (material)
  - (6) pump none (HP) (yield gpm)  
(type power)
  - (7) electric log (yes or no)  
(organization running log)
  - (8) how well bottom plugged not

**CODED**


JAN - 5 1970

DRILLERS REMARKS:

MISSISSIPPI  
BOARD OF WATER COMMISSIONERS  
WATER CONTROL

If well telescopes please sketch and show depths.

GROUND LEVEL

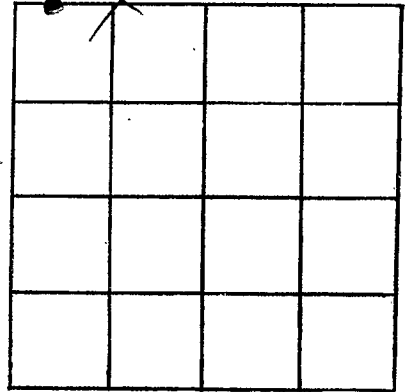

SECTION 15

Please indicate well location X.

ADDITIONAL INFORMATION

put 4" PVC plastic casing in old square wood curb well made by me in Sept. 1964 (Ref Page 183) & pumped down 3' below old well

If more than one screen, show locations of each on sketch.