

Marshall
 H 17
 2-5-70

MISSISSIPPI
 BOARD OF WATER COMMISSIONERS
 416 North State Street
 Jackson, Mississippi 39201

CODED

WATER WELL DRILLERS LOG

Feb. 5th 1970 date well completed
 With Mason water well contractor firm name
 Marshall Co. county well located

LANDOWNER: Mrs. Ruth R. Fland
 139 halia Miss.
 by order - J. P. Woods
 139 halia Miss.
 (mailing address)

description of formations encountered	from	to
Medium coarse sand	Red	
Water bearing sand		39 42

WELL LOCATION:
 sec. 1 T-3 N R-5 E
 1 1/4 miles S of Bynahalia
 (distance) (direction) (nearest town)

WELL PURPOSE: ~~tenant house~~
 (home, irrigation, municipal, industrial)
 Katie Wilson

- WELL COMPLETION DATA:
- (1) diameter (inches) 4
 - (2) total depth (feet) 42
 - (3) static water level (feet) 32 below above top of ground.
 - (4) casing (material) PVC plastic (depth) 42
 - (5) screen (size) 4" if telescope see back. (length) none (depth to top)
 - (6) pump (HP) none (material) (yield gpm)
 - (7) electric log no (yes or no)
 - (8) how well bottom plugged not

CODED


FEB 20 1970

DRILLERS REMARKS:

MISS. BD. OF
 WATER COMM.

If well telescopes please sketch and show depths.

GROUND LEVEL

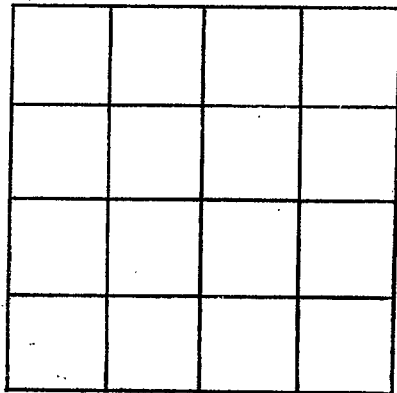

SECTION _____

Please indicate well location X.

ADDITIONAL INFORMATION

Reurb -

*Put 4" plastic casing
inside old Reurb
wood curb well
made by Frank
Mason approx. 20
years ago. Reurb
by me May 1958
Ref. Page 9*

If more than one screen,
show locations of each on sketch.