

MISSISSIPPI
BOARD OF WATER COMMISSIONERS
416 North State Street
Jackson, Mississippi 39201

no log
CODED
21 10

WATER WELL DRILLERS LOG

June 23rd. 1969 W.A. Mason Well Contractor Marshall

Marshall
H 18
6-69

date well completed 19 69 firm name W.A. Mason Well Contractor county well located Marshall

LANDOWNER: Richard Ramshur
Route One
Byhalia Miss.

(mailing address)

WELL LOCATION:
sec. 3 T. 3 N R. 5 E
SW of Byhalia
3 1/2 miles (distance) (direction) of (nearest town)

WELL PURPOSE: Mobile Home
(home, irrigation, municipal, industrial)

- WELL COMPLETION DATA:
- (1) diameter (inches) 2
 - (2) total depth (feet) 68
 - (3) static water level (feet) 50 ~~XXXX~~ *below top of ground*
 - galvanized steel 63ft.
 - (4) casing (material) (depth)
5ft. ~~XXXX~~
If telescope see back.
(size) 5ft. ~~XXXX~~
(5) screen (length) (depth to top)
1 1/2 in. 60 gauge CM&CO
(size) (material)
 - (6) pump (HP) (yield gpm)
electricity
(type power) yes
 - (7) electric log (yes or no)
red pump
(organization running log)
 - (8) how well bottom plugged
strainer point plug


description of formations encountered	from	to
Hard clay dirt	1	3
Red sand & gravel	3	6
Red gummy sand with few scattered rocks	6	30
soft red sand	30	48
clay red sand	48	50
thin sand rock	50	
red water sand	50	51
white pipe clay	51	58
grey fine yellowish sand (water bearing)	58	68

CODED

AUG 5 1969
MISS. ED. CO.
WATER SERVICE

DRILLERS REMARKS:

If well telescopes please sketch and show depths.

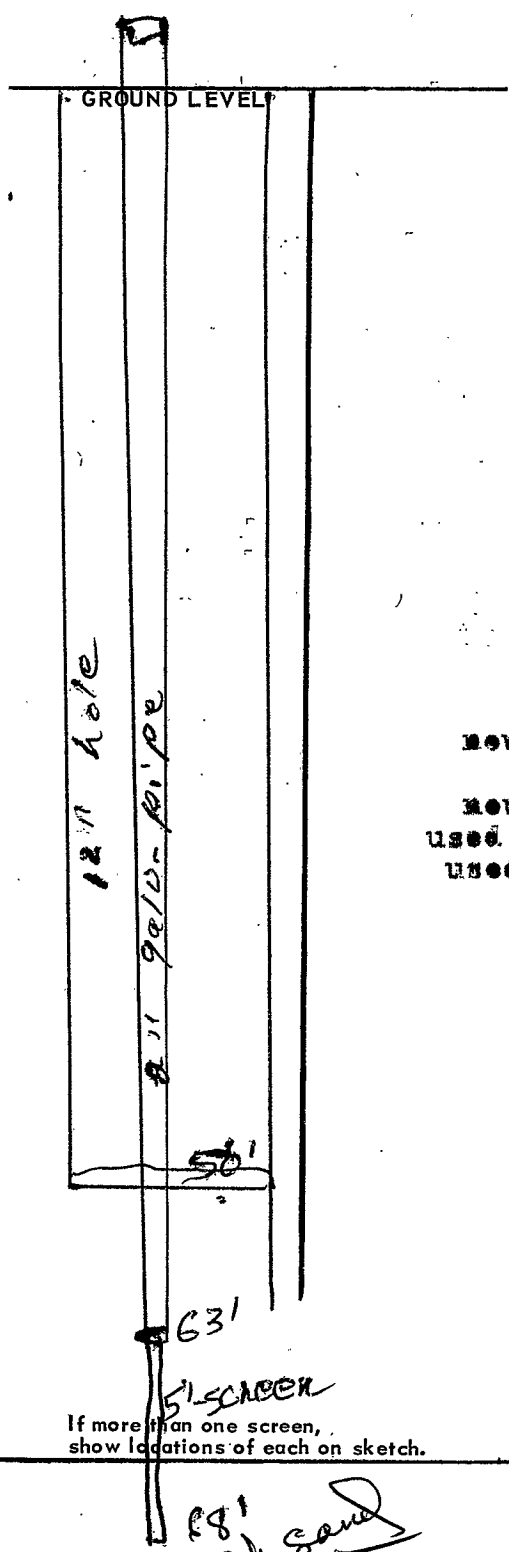

If more than one screen, show locations of each on sketch.

28'
Reddish sand
Fines

SECTION 3

Please indicate well location X.

ADDITIONAL INFORMATION

Parts

- new 63 ft. new 2 in. galv. pipe
- new 5ft. x 60 Gauze 1 1/4 in. I.D. screen
- new Eureka 1-13-16 in. cylinder
- used cook rods
- used Deming IO63 system