

Marshall
H 19
1-17-70

MISSISSIPPI
BOARD OF WATER COMMISSIONERS
416 North State Street
Jackson, Mississippi 39201



WATER WELL DRILLERS LOG

1-17-70 date well completed
Bumper Well Co. firm name
Marshall county well located

LANDOWNER:

Clarence Rhea
Byhalia, Miss.
(mailing address)

description of formations encountered

Clay
Sand

from	to
0	20
20	80

WELL LOCATION:


sec. 8 T 3 N R 5 E
4 miles South of Byhalia
(distance) (direction) (nearest town)

WELL PURPOSE:

(home, irrigation, municipal, industrial)

WELL COMPLETION DATA:

- (1) diameter (inches) 4"
- (2) total depth (feet) 80 feet
- (3) static water level (feet) 43 feet below top of ground.
- (4) casing PVC, 80 feet (material), (depth)
- (size) If telescope see back.
- (5) screen 6 ft, 74 feet (length), (depth to top)
- 4" gravel wall (size), (material)
- (6) pump 3/4 HP, 10 (yield gpm)
- (type power)
- (7) electric log elect. (yes or no)
- (organization running log)
- (8) how well bottom plugged 4" cap

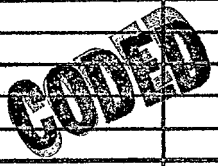


MAR 6 - 1970

MISS. BD. OF
WATER COMMISSIONERS

DRILLERS REMARKS:

If well telescopes please sketch and show depths.

GROUND LEVEL

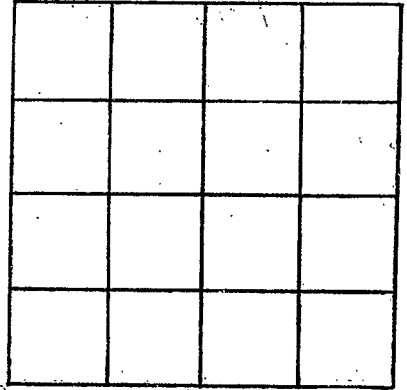

SECTION _____

Please indicate well location X.

ADDITIONAL INFORMATION

If more than one screen, show locations of each on sketch.